


Wellbore Schematic Input Report

Well Name: SWANSON 29-11


VERTICAL - ORIGINAL HOLE, 1/10/2018 10:27:04 AM

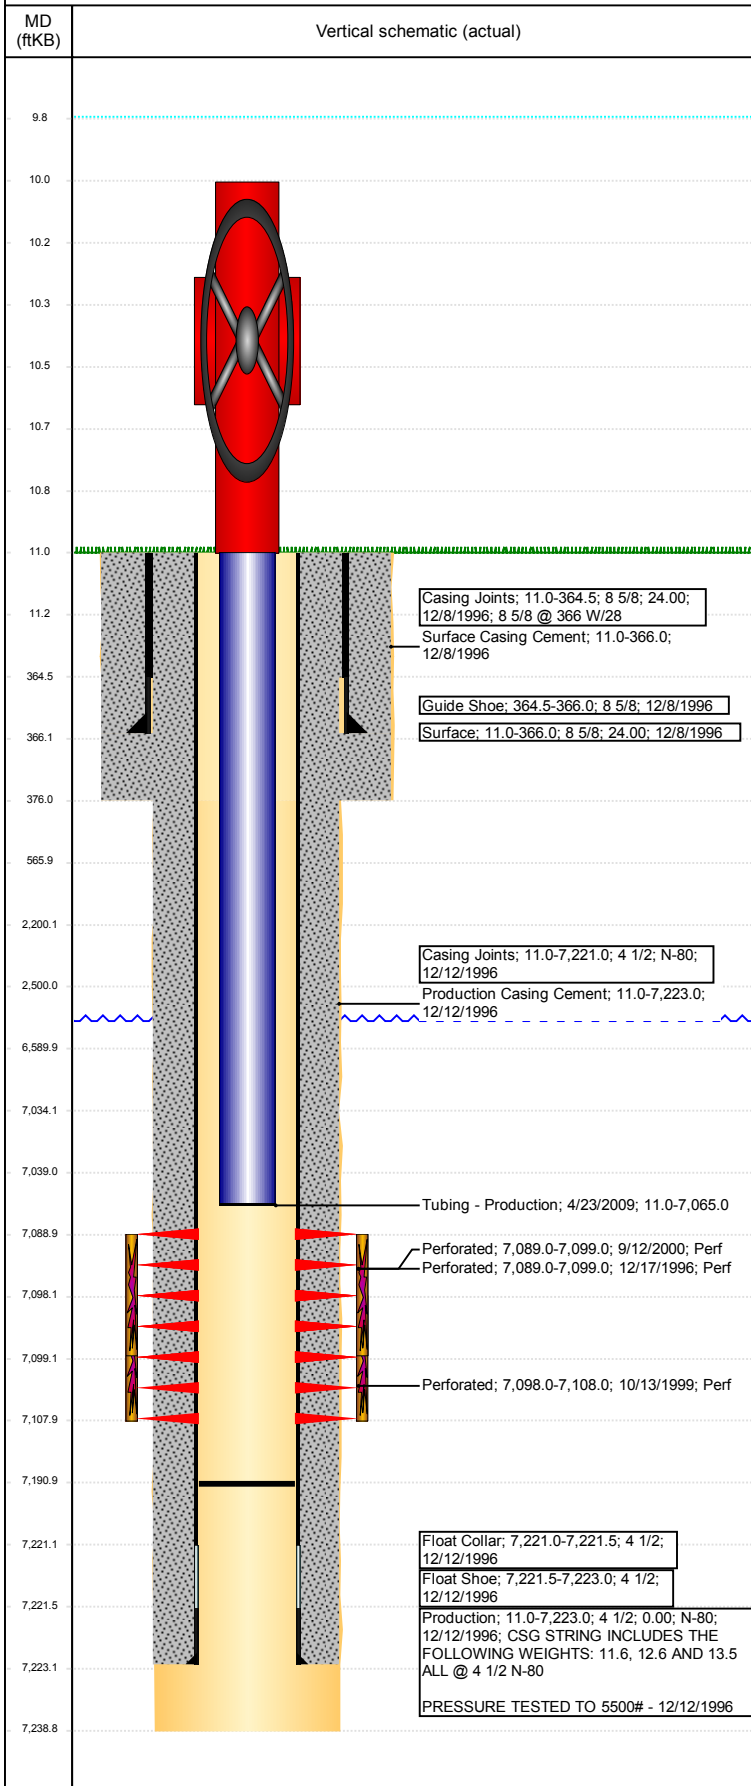

Well Header								
API 05-123-19252		Business Unit DJ BASIN		District 15		Well Config VERTICAL		
Original KB Elevation (ft) 4,734		KB - GL / MSL (ftKB) 11.00		Spud Date 12/7/1996		P & A Date		
Comment DISCREP- ST RPT BIT 2 6 1/4, DRL RPT 7 7/8 PROD CSG STRING INCLUDES THE FOLLOWING WEIGHTS: 11.6, 12.6 AND 13.5 ALL @ 4 1/2 N-80								
Directions To Well HWY 85 NORTH TO GRELLEY BY-PASS, TAKE BY-PASS NORTH TO HWY 392, WEST TO ROAD 29, SOUTH TO ROAD 66, WEST 0.1 MILE, SOUTH INTO LOCATION.								
Congressional Location								
Quarter 3 NE	Quarter 4 NE	Section 29	Township 6	Twtnshp N/S Dir N	Range 66	Range E/W Dir W		
Bottom Hole Location								
North-South Distance (ft)		From N or S Line		East-West Distance (ft)		From E or W Line		
Plug Back Total Depths								
Date	Depth (ftKB)	Method			Com			
12/12/1996	7,193.0	CASING TALLY						
4/22/2009	7,191.0	TAG						
Wellbore Sections								
Section Des		Size (in)		Act Top, MD (ftKB)		Act Btm, MD (ftKB)		
SURFACE		12 1/4		11		376		
PRODUCTION		7 7/8		376		7,239		
Zone Statuses								
Zone Name	Status Date	Status	Fluid Type	Job	Prod Method			
CODELL	12/24/1996	PR	Oil	DRILLING/CO...	Flowing			
CODELL	9/28/2000	PR	Oil	RECOMPLETI...				
CODELL	11/15/2010	PR	Water					
CODELL	12/12/2015	PR						
CODELL	1/28/2016	PR						
Casing Strings								
Surface, 366.0ftKB								
Casing Description Surface		Run Date 12/8/1996	OD (in) 8 5/8	Wt/Len (l... 24.00	Grade	Top, MD (ft... 11.0	MD (ftKB) 366.0	
Production, 7,223.0ftKB								
Casing Description Production		Run Date 12/12/1996	OD (in) 4 1/2	Wt/Len (l... N-80	Grade	Top, MD (ft... 11.0	MD (ftKB) 7,223.0	
Cement								
Description Surface Casing Cement				Top Depth (ftKB) 11.0		Bottom Depth (ftKB) 366.0		
Description Production Casing Cement				Top Depth (ftKB) 11.0		Bottom Depth (ftKB) 7,223.0		
Description Cement Plug				Top Depth (ftKB) 6,590.0		Bottom Depth (ftKB) 7,034.0		
Description Shoe Plug				Top Depth (ftKB) 11.0		Bottom Depth (ftKB) 566.0		
Description Balance Plug				Top Depth (ftKB) 2,200.0		Bottom Depth (ftKB) 2,500.0		
Tubing Strings								
Tubing Description Tubing - Production		Run Date 4/23/2009	String... 2 3/8	ID (in)	Wt (lb/ft)	Grade	Len (ft) 7,054.00	Set De...
Tubing Components								
Item Des		OD (in)	Wt (lb/ft)	Grade	Jts	Len (ft)	Btm (ftKB)	Btm (TVD) (ftKB)
Tubing		2 3/8			224	7,052.50	7,063.5	
Seal Nipple		2 3/8				1.00	7,064.5	
Notched collar		2 3/8				0.50	7,065.0	
Other In Hole								
Run Date		Des			OD (in)	Top (ftKB)	Btm (ftKB)	
1/8/2018		Cast Iron Bridge Plug			3.99	7,034.0	7,039.0	
Logs								
Date		Type				Top, MD (ftKB)	Btm, MD (ftKB)	
12/11/1996		COMPENSATED DENSITY				366.0	7,245.0	
12/11/1996		INDUCTION				366.0	7,245.0	
12/14/1996		SONIC				6,180.0	7,182.0	

Well Name: SWANSON 29-11

VERTICAL - ORIGINAL HOLE, 1/10/2018 10:27:04 AM

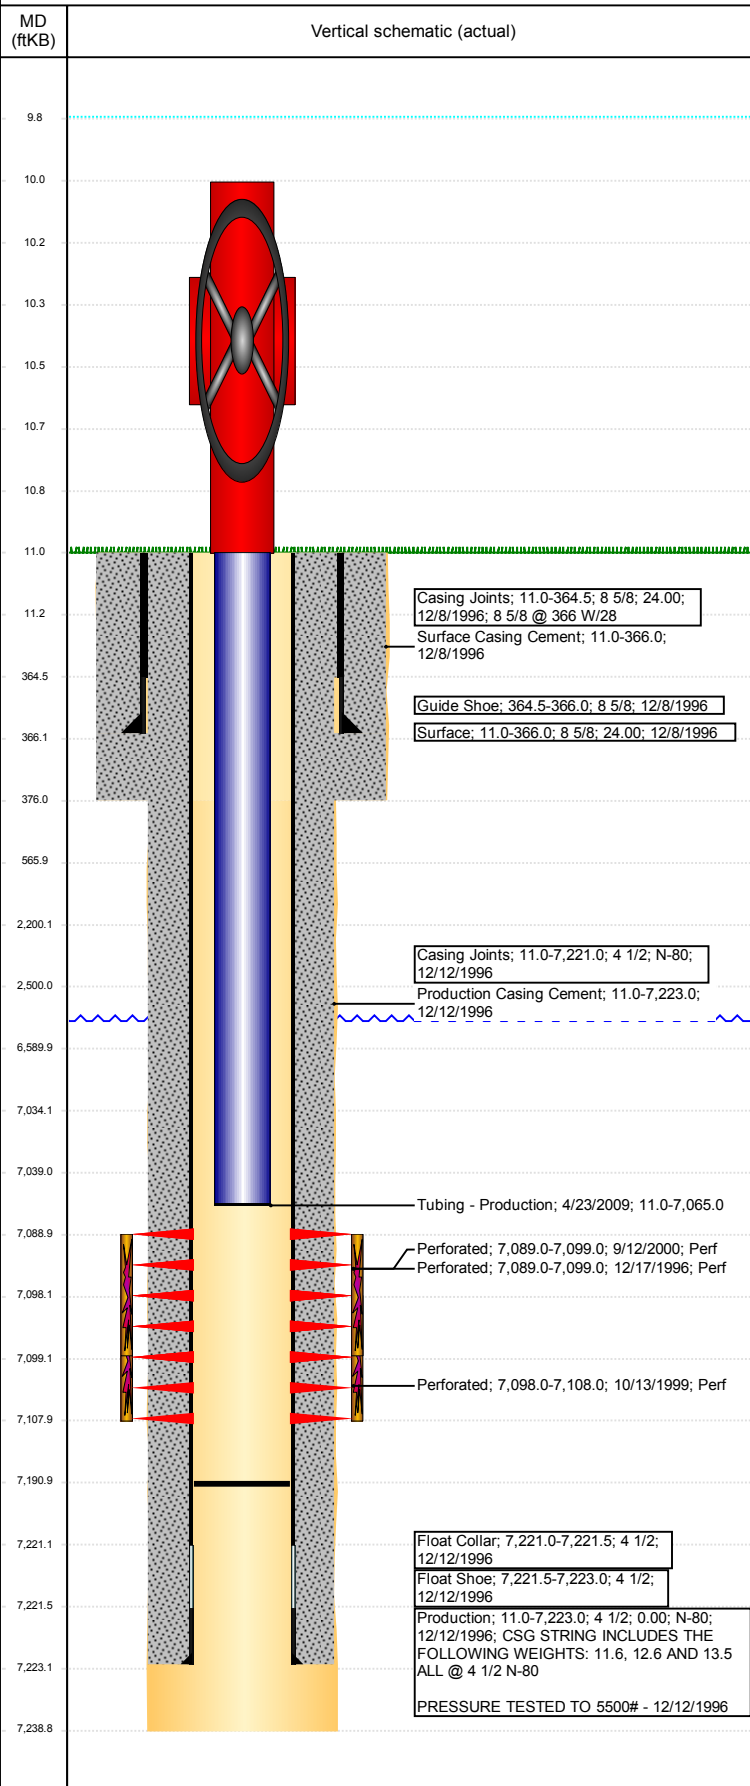

Logs					
Date		Type		Top, MD (ftKB)	Btm, MD (ftKB)
12/28/1996		CBL/CCL/GR			
Perforation Data					
Linked Zone	Bnch/St g	Sum of Entered Shot Total	Top (ftKB)	Btm (ftKB)	Date
CODELL, ORIGINAL HOLE		40	7,089.00	7,099.00	9/12/2000
CODELL, ORIGINAL HOLE		40	7,089.00	7,099.00	12/17/1996
CODELL, ORIGINAL HOLE		40	7,098.00	7,108.00	10/13/1999
Total (Sum)		120			
Stimulation Intervals					
Start Date		Primary Job Type			
12/18/1996		DRILLING/COMPLETION - ORIGINAL			
Technical Result		Tech Result Details		Tech Result Note	
Comment					
Start Date		Primary Job Type			
10/13/1999		RECOMPLETION			
Technical Result		Tech Result Details		Tech Result Note	
Comment					
Start Date		Primary Job Type			
9/19/2000		RECOMPLETION			
Technical Result		Tech Result Details		Tech Result Note	
Comment					