




CERTIFICATE OF SURVEY
for
Snyder Drilling Co.
Adams County, Colorado

RECEIVED

SEP 12 1973

COLORADO OIL & GAS COMMISSION

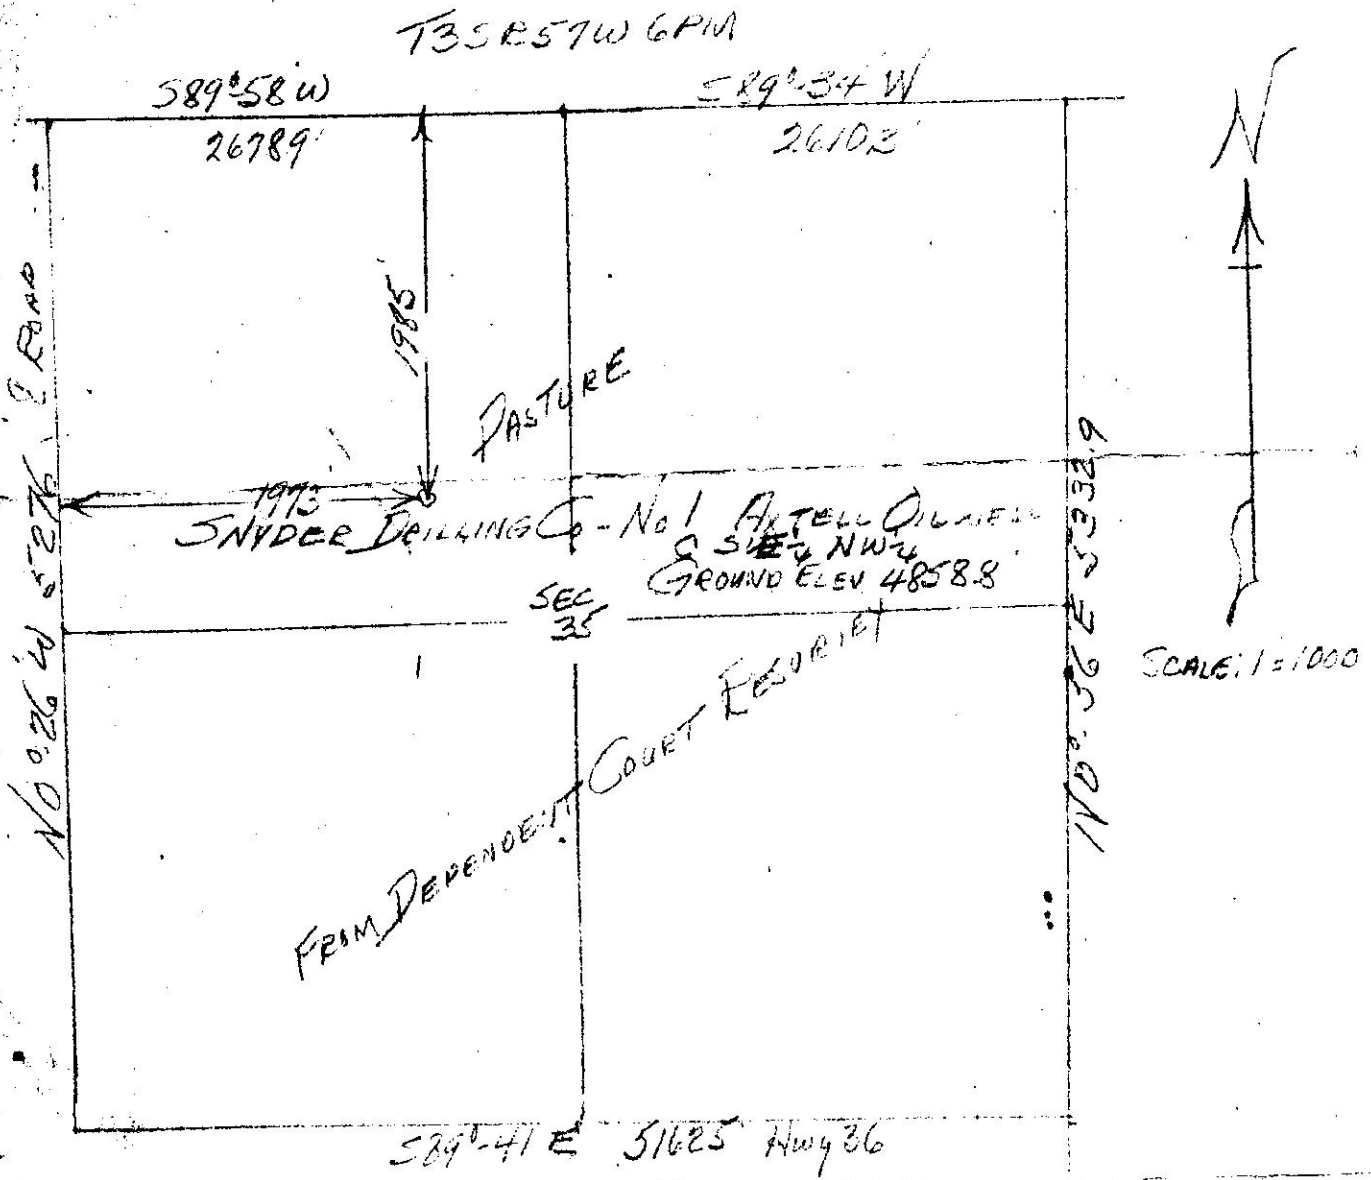

I hereby certify that the above plat is an accurate representation of a correct survey showing the location of Snyder Drilling Co. - No. 1 Artell Oilwell in G S 1/4 NW 1/4 Sec. 35 T3S R57W 6PM. The elevation of the ground at the stake is 4858.8 feet above sea level from U.S.C.&G. Bench Mark.

Fort Morgan, Colorado
Sept. 1, 1973

Cecil J. Clatome
Registered Professional Engineer
State of Colorado

TB-666