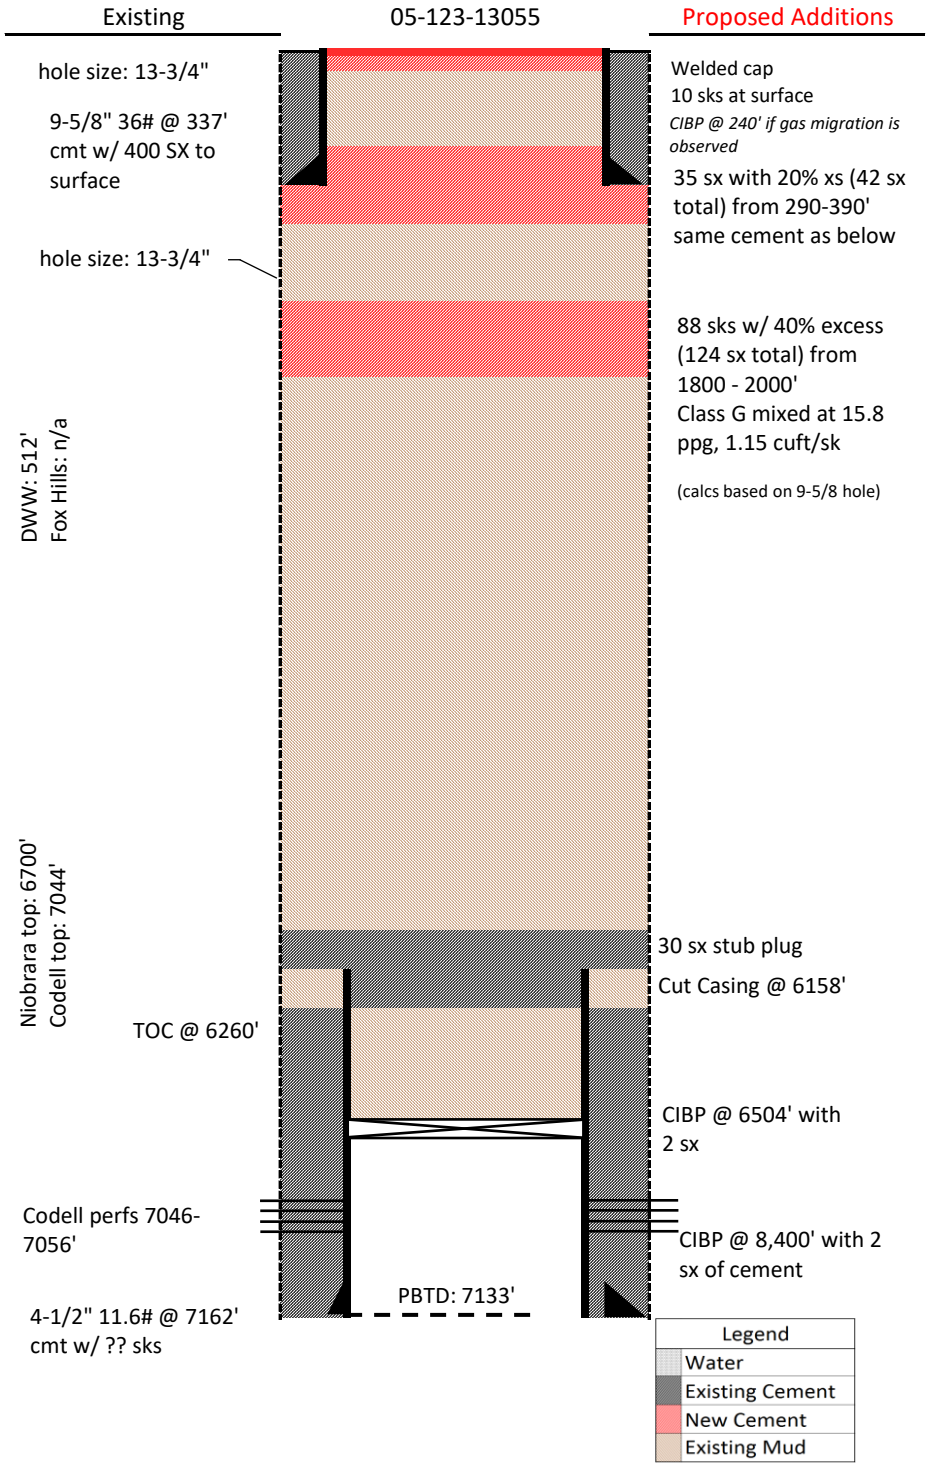WELLBORE DIAGRAM
FRANCIS ENERGY INC
DAVIS 1
SESW 33 6N 65W
WELD COUNTY
05-123-13055