


API:	05-123-11412	ELEVATION:	4941	QTR-QTR:	SWNW
WELL NAME:	FLOYD ADLER GU B TRUE 1	GROUND LEVEL:	4928	SECTION:	34
COUNTY:	WELD	MD:	7805	TOWNSHIP:	3N
LATITUDE:	40.18543	PBMD:	7760	RANGE:	68W
LONGITUDE:	-104.99429	CREATED BY:	D. HASZ		
		DATE:	1/30/2018		

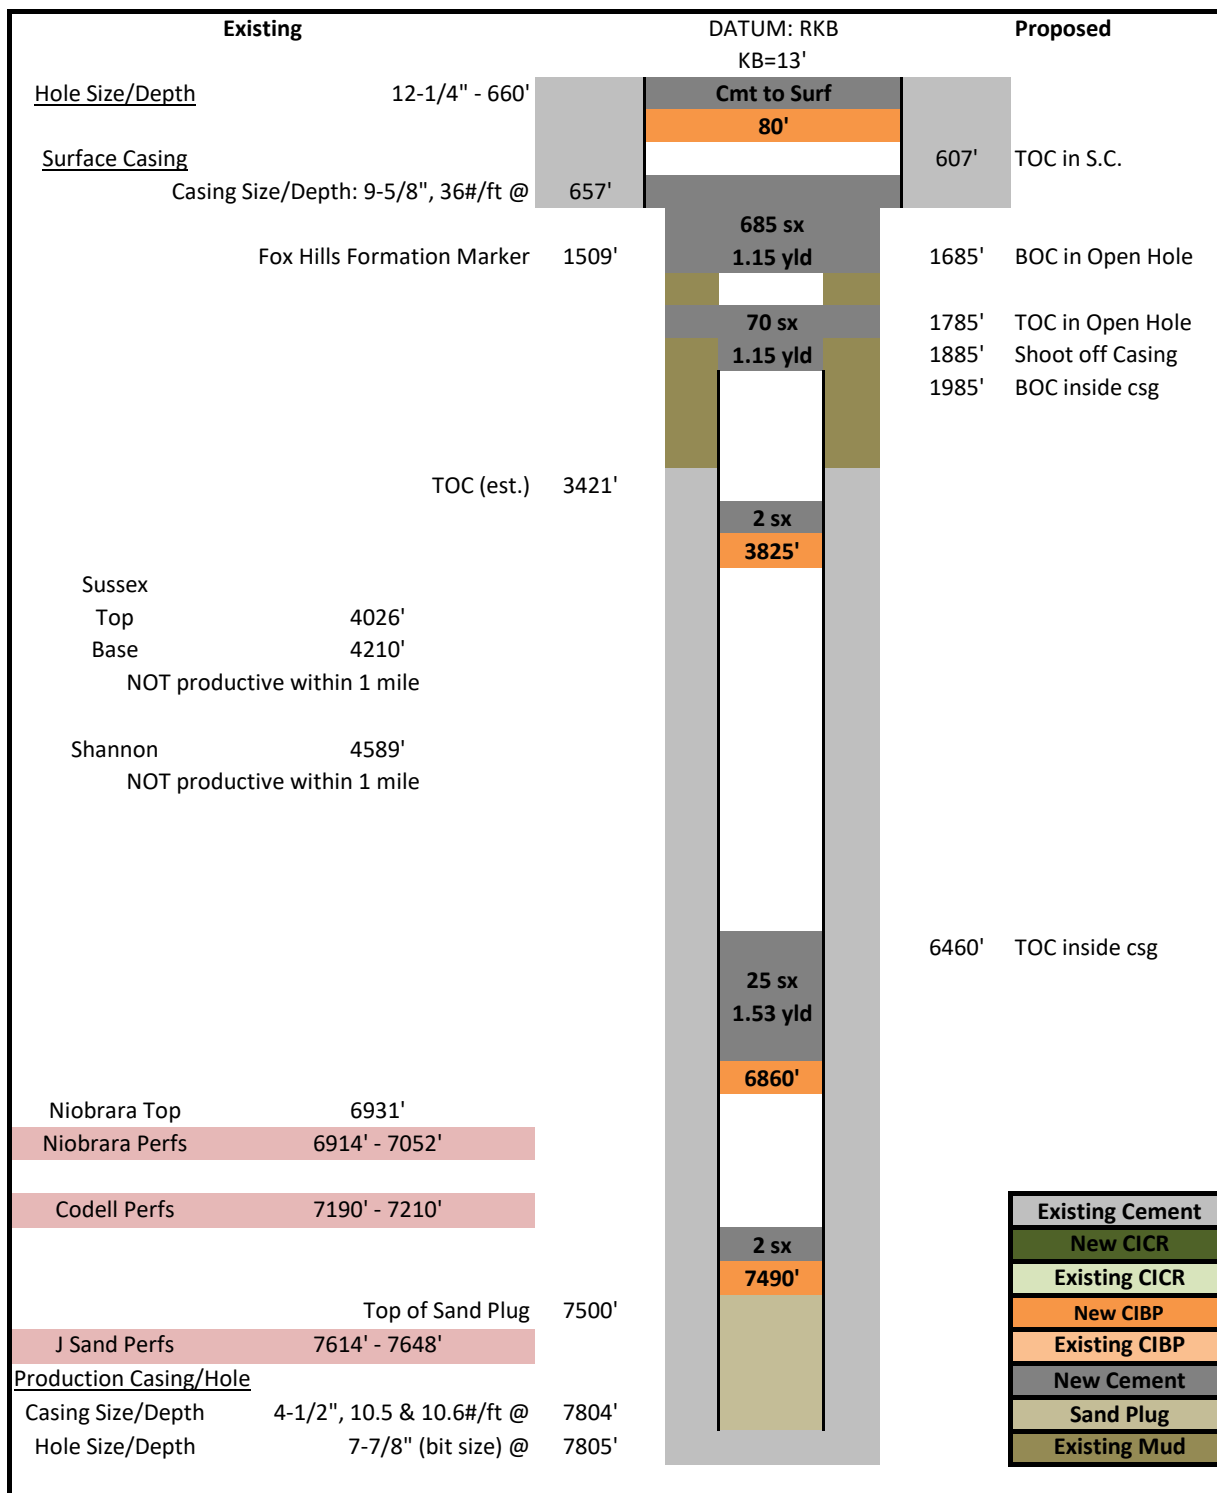

Note: Documentation appears to indicate that this well's legal name is the Floyd Adler GU "B" True #1, however some later documents call this well the Lloyd Adler GU "B" True #1 creating the possibility of confusion.