

**T. 6 S.**  
**CC FEDERAL**  
**0697-04-05W**  
**TOP OF CONCRETE**  
**ELEVATION: 8528.8'**

BASIS OF ELEVATION: USGS SPOT ELEVATION LOCATED AT THE SE CORNER OF SECTION 4, T6S, R97W ELEVATION: 8387'

**SHL**  
**LATITUDE (NAD 83)**  
 NORTH 39.553322 DEG.  
**LONGITUDE (NAD 83)**  
 WEST 108.233281 DEG.  
**NORTHING (NAD 83)**  
 1638019.06  
**EASTING (NAD 83)**  
 2229411.32

**BASIS OF BEARING/DATUM**  
 SPCS COLORADO CENTRAL NAD 27 BASED ON GPS OBSERVATIONS AND OPUS SOLUTION ON DRG CONTROL POINT "WILLIAMS" HAVING A POSITION OF:  
 NAD83(2011)  
 LAT 39° 31' 35.18" NORTH  
 LONG 108° 12' 16.79" WEST  
 NAVD88 ELEVATION: 8618.14'

THE SOUTH LINE OF THE SW¼ OF SECTION 4, MONUMENTED BY BLM BC'S AND BEARING N88°15'34"W.

**BHL/TOG**  
**LATITUDE (NAD 83)**  
 NORTH 39.559646 DEG.  
**LONGITUDE (NAD 83)**  
 WEST 108.229485 DEG.  
**NORTHING (NAD 83)**  
 1640289  
**EASTING (NAD 83)**  
 2230550

**NOTES**

1. GPS OPERATOR J. SEAL OBSERVED A PDOP OF 1.8.
2. ALL GPS OBSERVATIONS ARE IN COMPLIANCE WITH COGCC RULE No.215.
3. EXISTING IMPROVEMENTS WITHIN 400' OF LOCATION. SEE LOC. DRAWING.
4. SURROUNDING SURFACE USE IS NATIVE BRUSH, NON CROP RANGELAND.

**LEGEND**


- ◆ WELL LOCATION
- APPROX. BHL
- └ DENOTES 90° TIE
- FOUND MONUMENT
- CALCULATED CORNER

**SURVEYOR'S STATEMENT**

I, DAVID E. HENDERHAN, AN EMPLOYEE AND AGENT ON BEHALF OF D.R. GRIFFIN & ASSOCIATES, INC. STATE THE PLAT HEREON IS A CORRECT REPRESENTATION OF A SURVEY MADE UNDER MY SUPERVISION ON THE 13th DAY OF JANUARY, 2012 OF THE SHOWN CC FEDERAL 0697-04-05W AS-DRILLED CONDUCTOR.

Notice: In accordance with Colorado State Law, any legal action based upon any defect in this survey plat must commence within three (3) years after first discovery of such defect. In no event, may any action based upon any defect in this survey plat be commenced more than ten (10) years from the date of certification shown hereon.

**CC 604-12-13 ANNEX PAD**

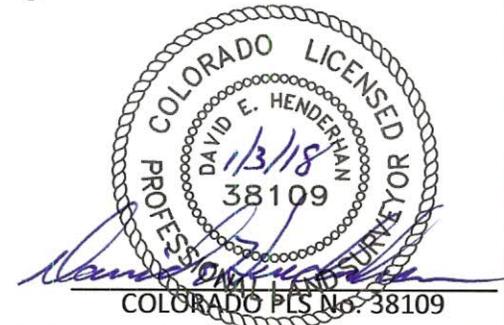

COLORADO PLS No. 38109

**DRG GRIFFIN & ASSOCIATES, INC.**  
 (307) 362-5028 1414 ELK ST., ROCK SPRINGS, WY 82901

DRAWN: 12/26/2017 - DEH	SCALE: 1" = 1000'
REVISED: N/A -	DRG JOB No. 21376
	B10-04-05W

**PLAT OF AS-DRILLED CONDUCTOR**  
**IN LOT 16, SECTION 4, FOR**  
**LARAMIE ENERGY, LLC.**  
**3140' F/SL, & 249' F/WL, SECTION 4,**  
**T. 6 S., R. 97, 6TH P.M.,**  
**GARFIELD COUNTY, COLORADO**