

IMAGE COURTESY OF GOOGLE EARTH 2017

LEGEND

- | | | | |
|---------------------------------------|--------------------|---|-------------------|
| X | RELEASE LOCATION | | EXCAVATION EXTENT |
| ● | SOIL SAMPLE | | BERM |
| ⊕ | GROUNDWATER SAMPLE | | REMOVED BERM |
| AST: ABOVEGROUND STORAGE TANK | | | |

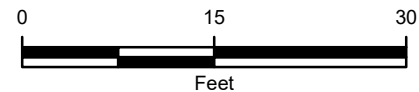


FIGURE 2
EXCAVATION SITE MAP
 HATCH UPRR 42-11 #1
 SENE SEC 11-T3N-R66W
 WELD COUNTY, COLORADO
 KERR-MCGEE OIL & GAS ONSHORE LP

