



DEPARTMENT OF NATURAL
RESOURCES
P.O. Box 2651
Durango, CO 81302-2651
Phone: (970) 259-1619
FAX: (970) 259-9128
www.cogcc.state.co.us

Fax

To: Johnny Frank – Hydro Technologies **From:** Karen Spray *Kare*
Fax: ~~970-247-0487~~ 884-0344 **Pages:** 3
Phone: **Date:** 05/30/2008
Re: Kempinski Data & W-9 **CC:**

Urgent **For Review** **Please Comment** **Please Reply** **Please Recycle**

Hi Guys –

I'm attaching the Kempinski well yield test data for your records. I would be curious to get your evaluation and a well yield number since you do it on a routine basis. Any chance you could provide that with the invoice?

And since I haven't seen the invoice yet, I'm attaching a W-9 that you can fill out and submit w/ the invoice so I can get you paid quickly. The sooner the better as our fiscal year ends on June 30, so I need to have all paperwork in by then.

Were you able to get Bernie's well fixed for him too? I am sure he would appreciate it.


Thanks for all the help – even when it rained! Now it's time for summer sunshine.

Ta,

Kempinski
well Yield test.
5/15/2008

| Time | Water Level |
|------|-----------------------------|
| 1028 | 292 |
| 1029 | 297 |
| 1030 | 300 |
| 1031 | 305 |
| 1032 | 309 |
| 1033 | 312 |
| 1035 | 324 |
| 1037 | 332 |
| 1039 | 343 |
| 1044 | 360 |
| 1049 | 381 |
| 1054 | 402 |
| 1059 | 434 |
| 1100 | 437 pump off begin recovery |
| 1110 | 421 |
| 1115 | 412 |
| 1120 | 411 |
| 1150 | 407.5 |
| 1210 | 404 |
| 1230 | 399 |
| 1245 | 395 |
| 1315 | 390 |
| 1325 | 389.5 |

7/13/1998

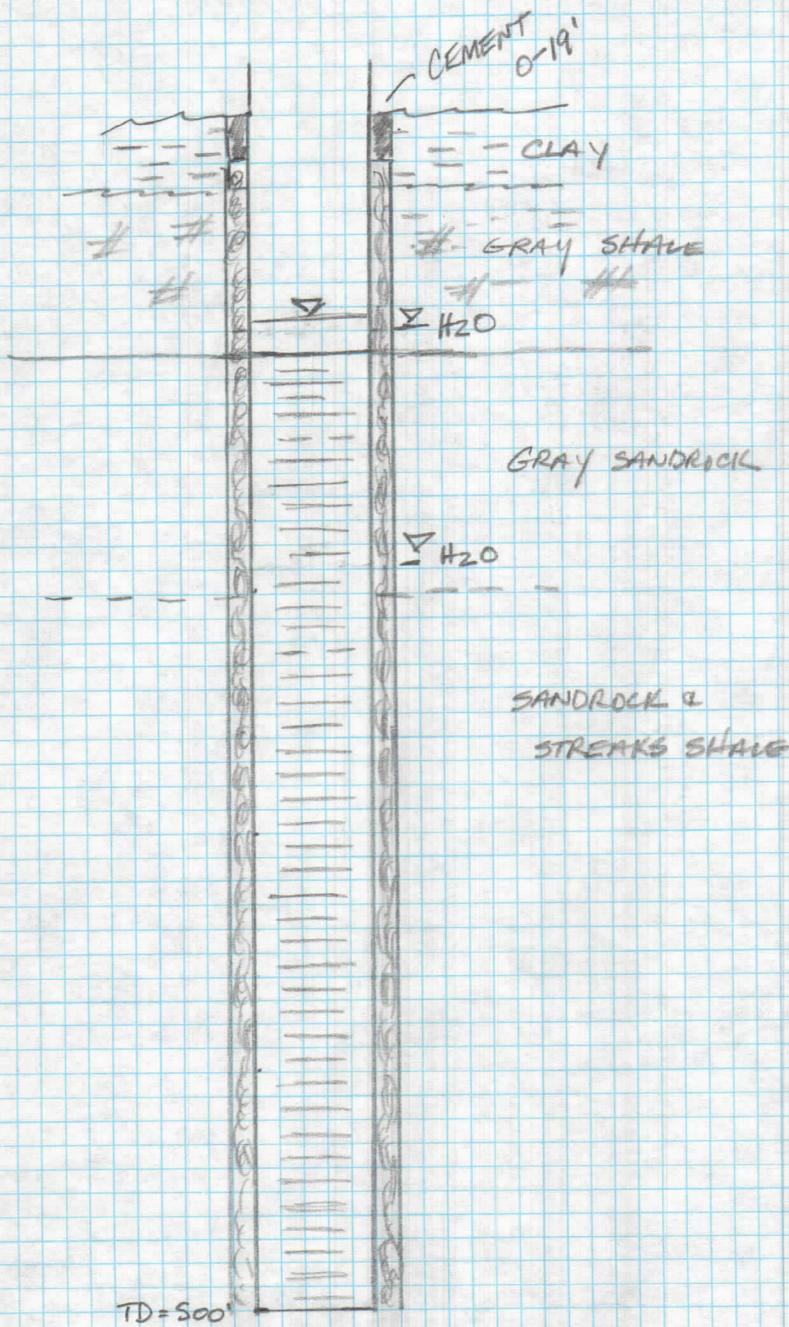

GRAVEL PACK
= 19-500' 1/2"

in well
330 gal @ .82 gal/ft
4 1/2" PK 100-500
(400')
8" hole 20-500
(480')
2.611 gal/ft.
1,044 gallons
in bore