


FINAL P&A WELLBORE DIAGRAM

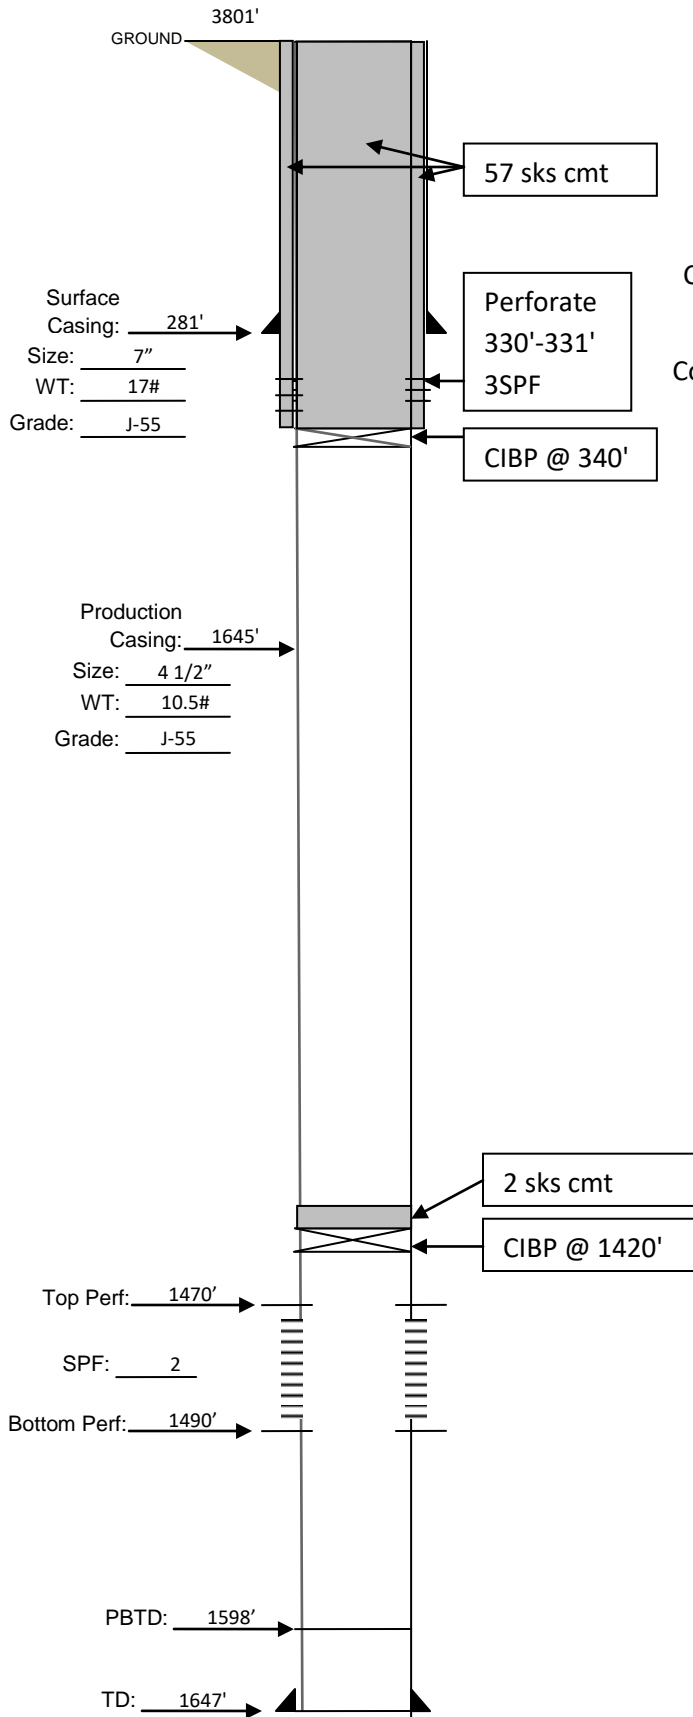

Well: Weyerman 6-18

API: 05-125-06706-00

Location: 2310' FWL & 1500' FNL, SENW
Sec. 18, T5S-R43W; ELEV GL 3751'

County, State: Yuma, CO

Date: 2-22-2018

Co. Supervisor: Roelfs

Lat/Longs: 39.626319 / -102.2243