


# IRISH PAD

As permitted  
Sundries required to swap surface locations  
for Sligo and Shamrock wells

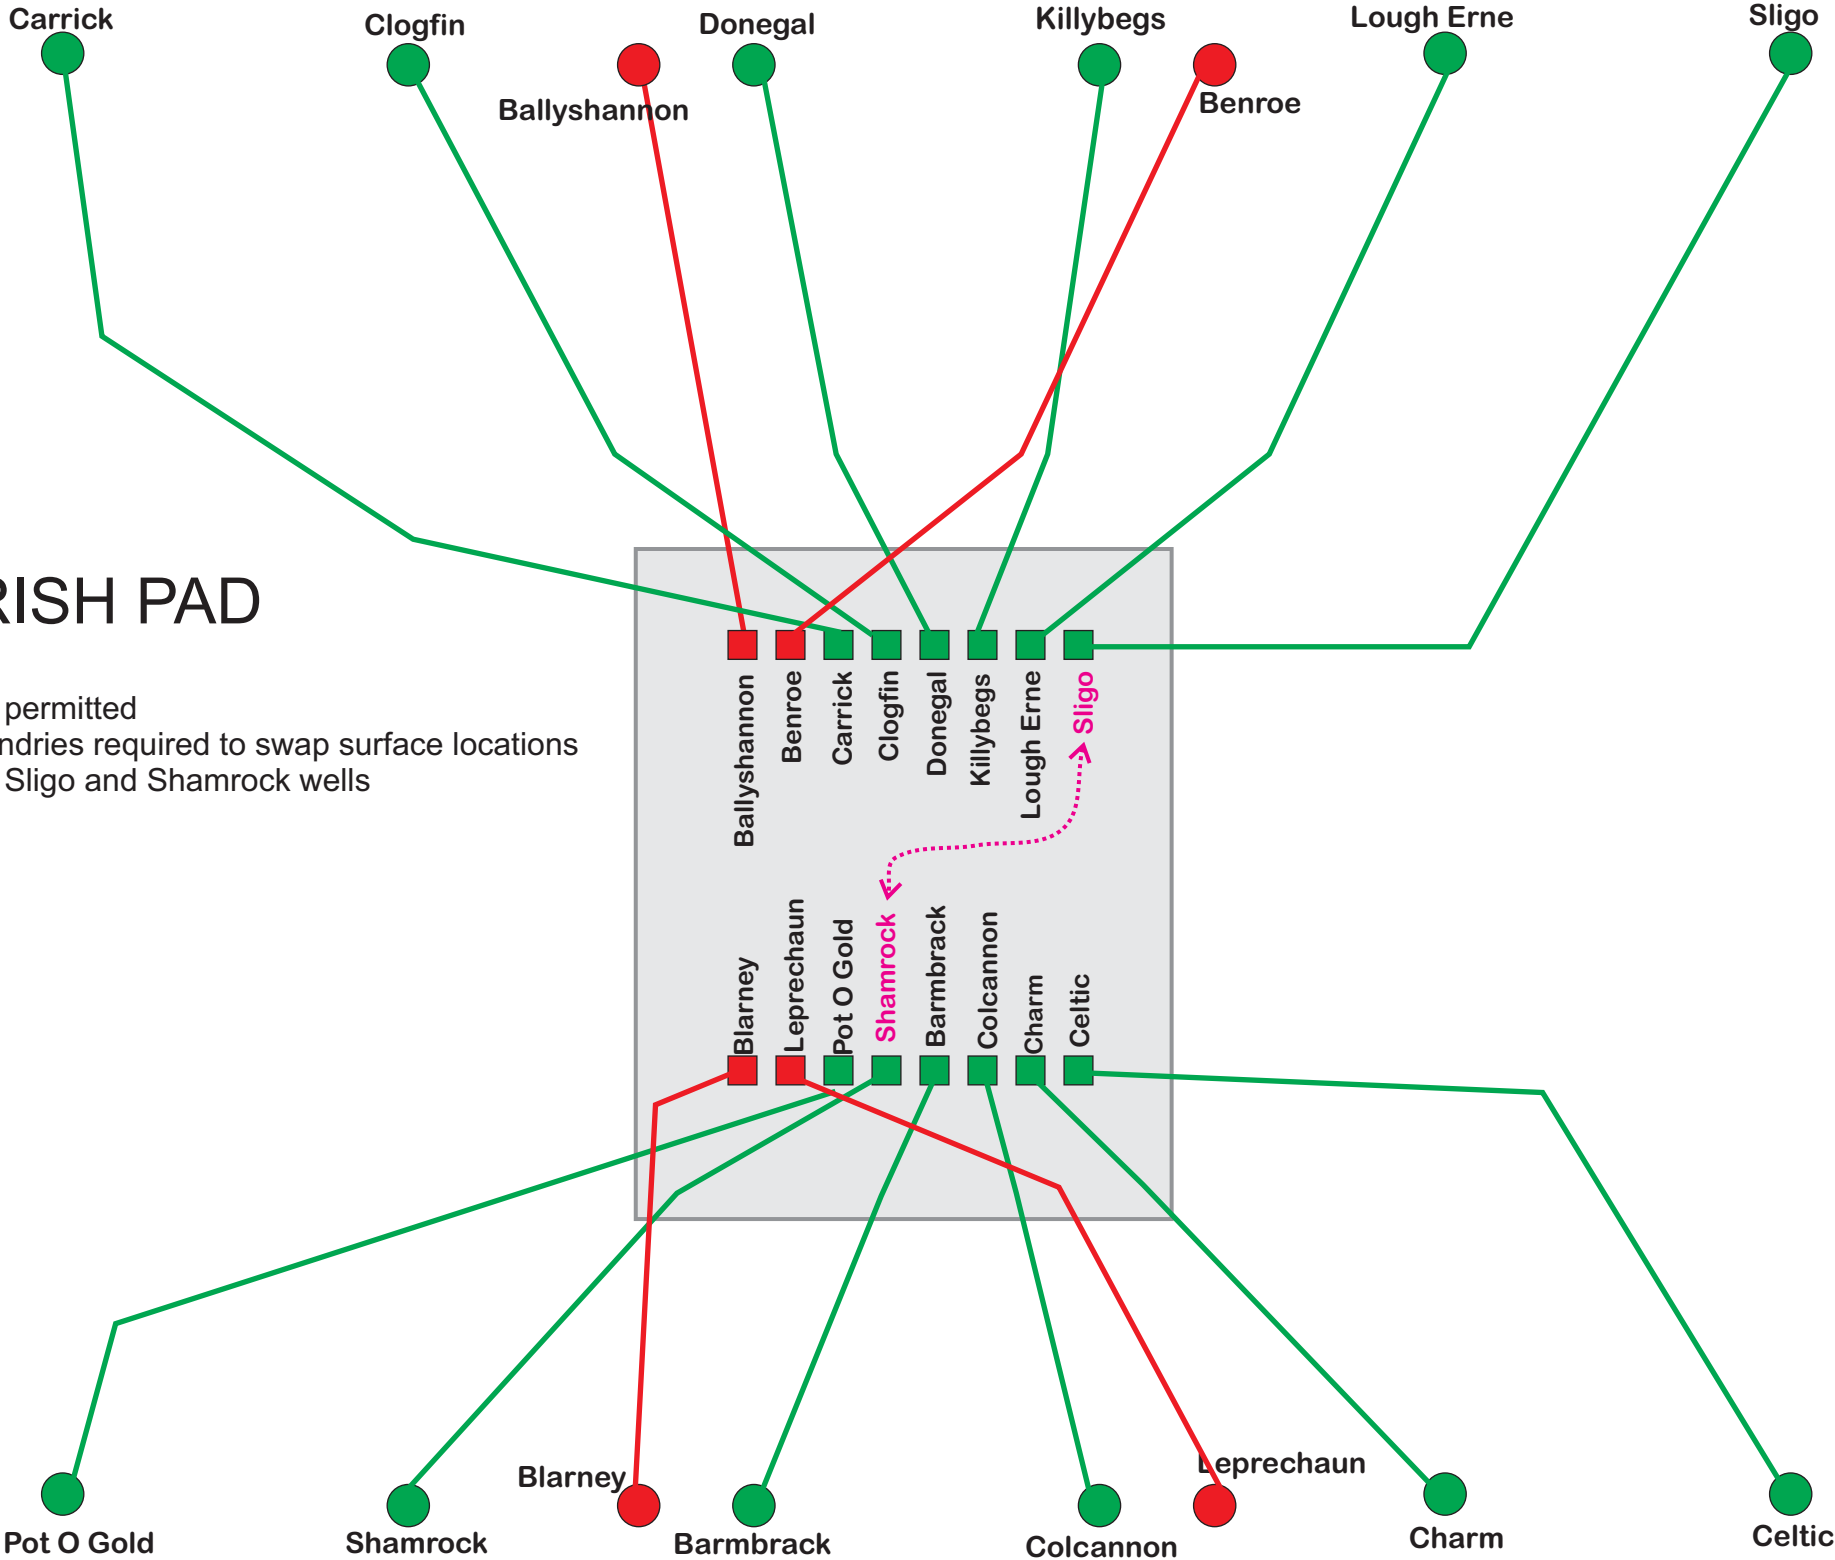

# IRISH PAD

Post-Sundry  
Sundries required to swap surface locations  
for Sligo and Shamrock wells

