

Configuration


Laws 1-17
NESW 17 7N66W 6 PM

6 ft , cap
12 1/2 hole

327 ft. 8 5/8 24# surface csg

7 7/8 hole
4 1/2 16.6 #

4 sks cmt
CIBP Set at 7100 ft

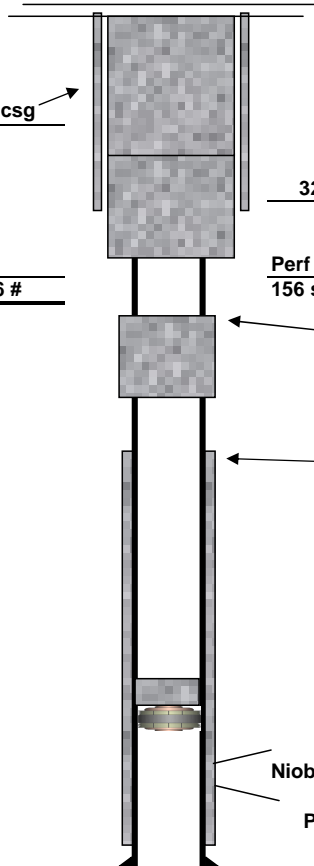

KB Elevation
Ground Elevation
Surface Casing

	15
	5001.6 ft
	4986.6 ft
327	8 5/8 24 #
350 sx	

Production Casing

4 1/2 16.6 #

TD 7637
PBTD 7560

327 ft 350 sks

Perf @ 377 ft.
156 sks

Perforate @ 1000 ft
75 sks cmt

Cement Tops at 6322 ft Bond Log
625 sks

Niobrara - Codell

7210-7470 2 spf

PBTD
TD

7560 ft. kb
7637 ft. kb

Loggers PBTD