



PLAT 10
Current Footage

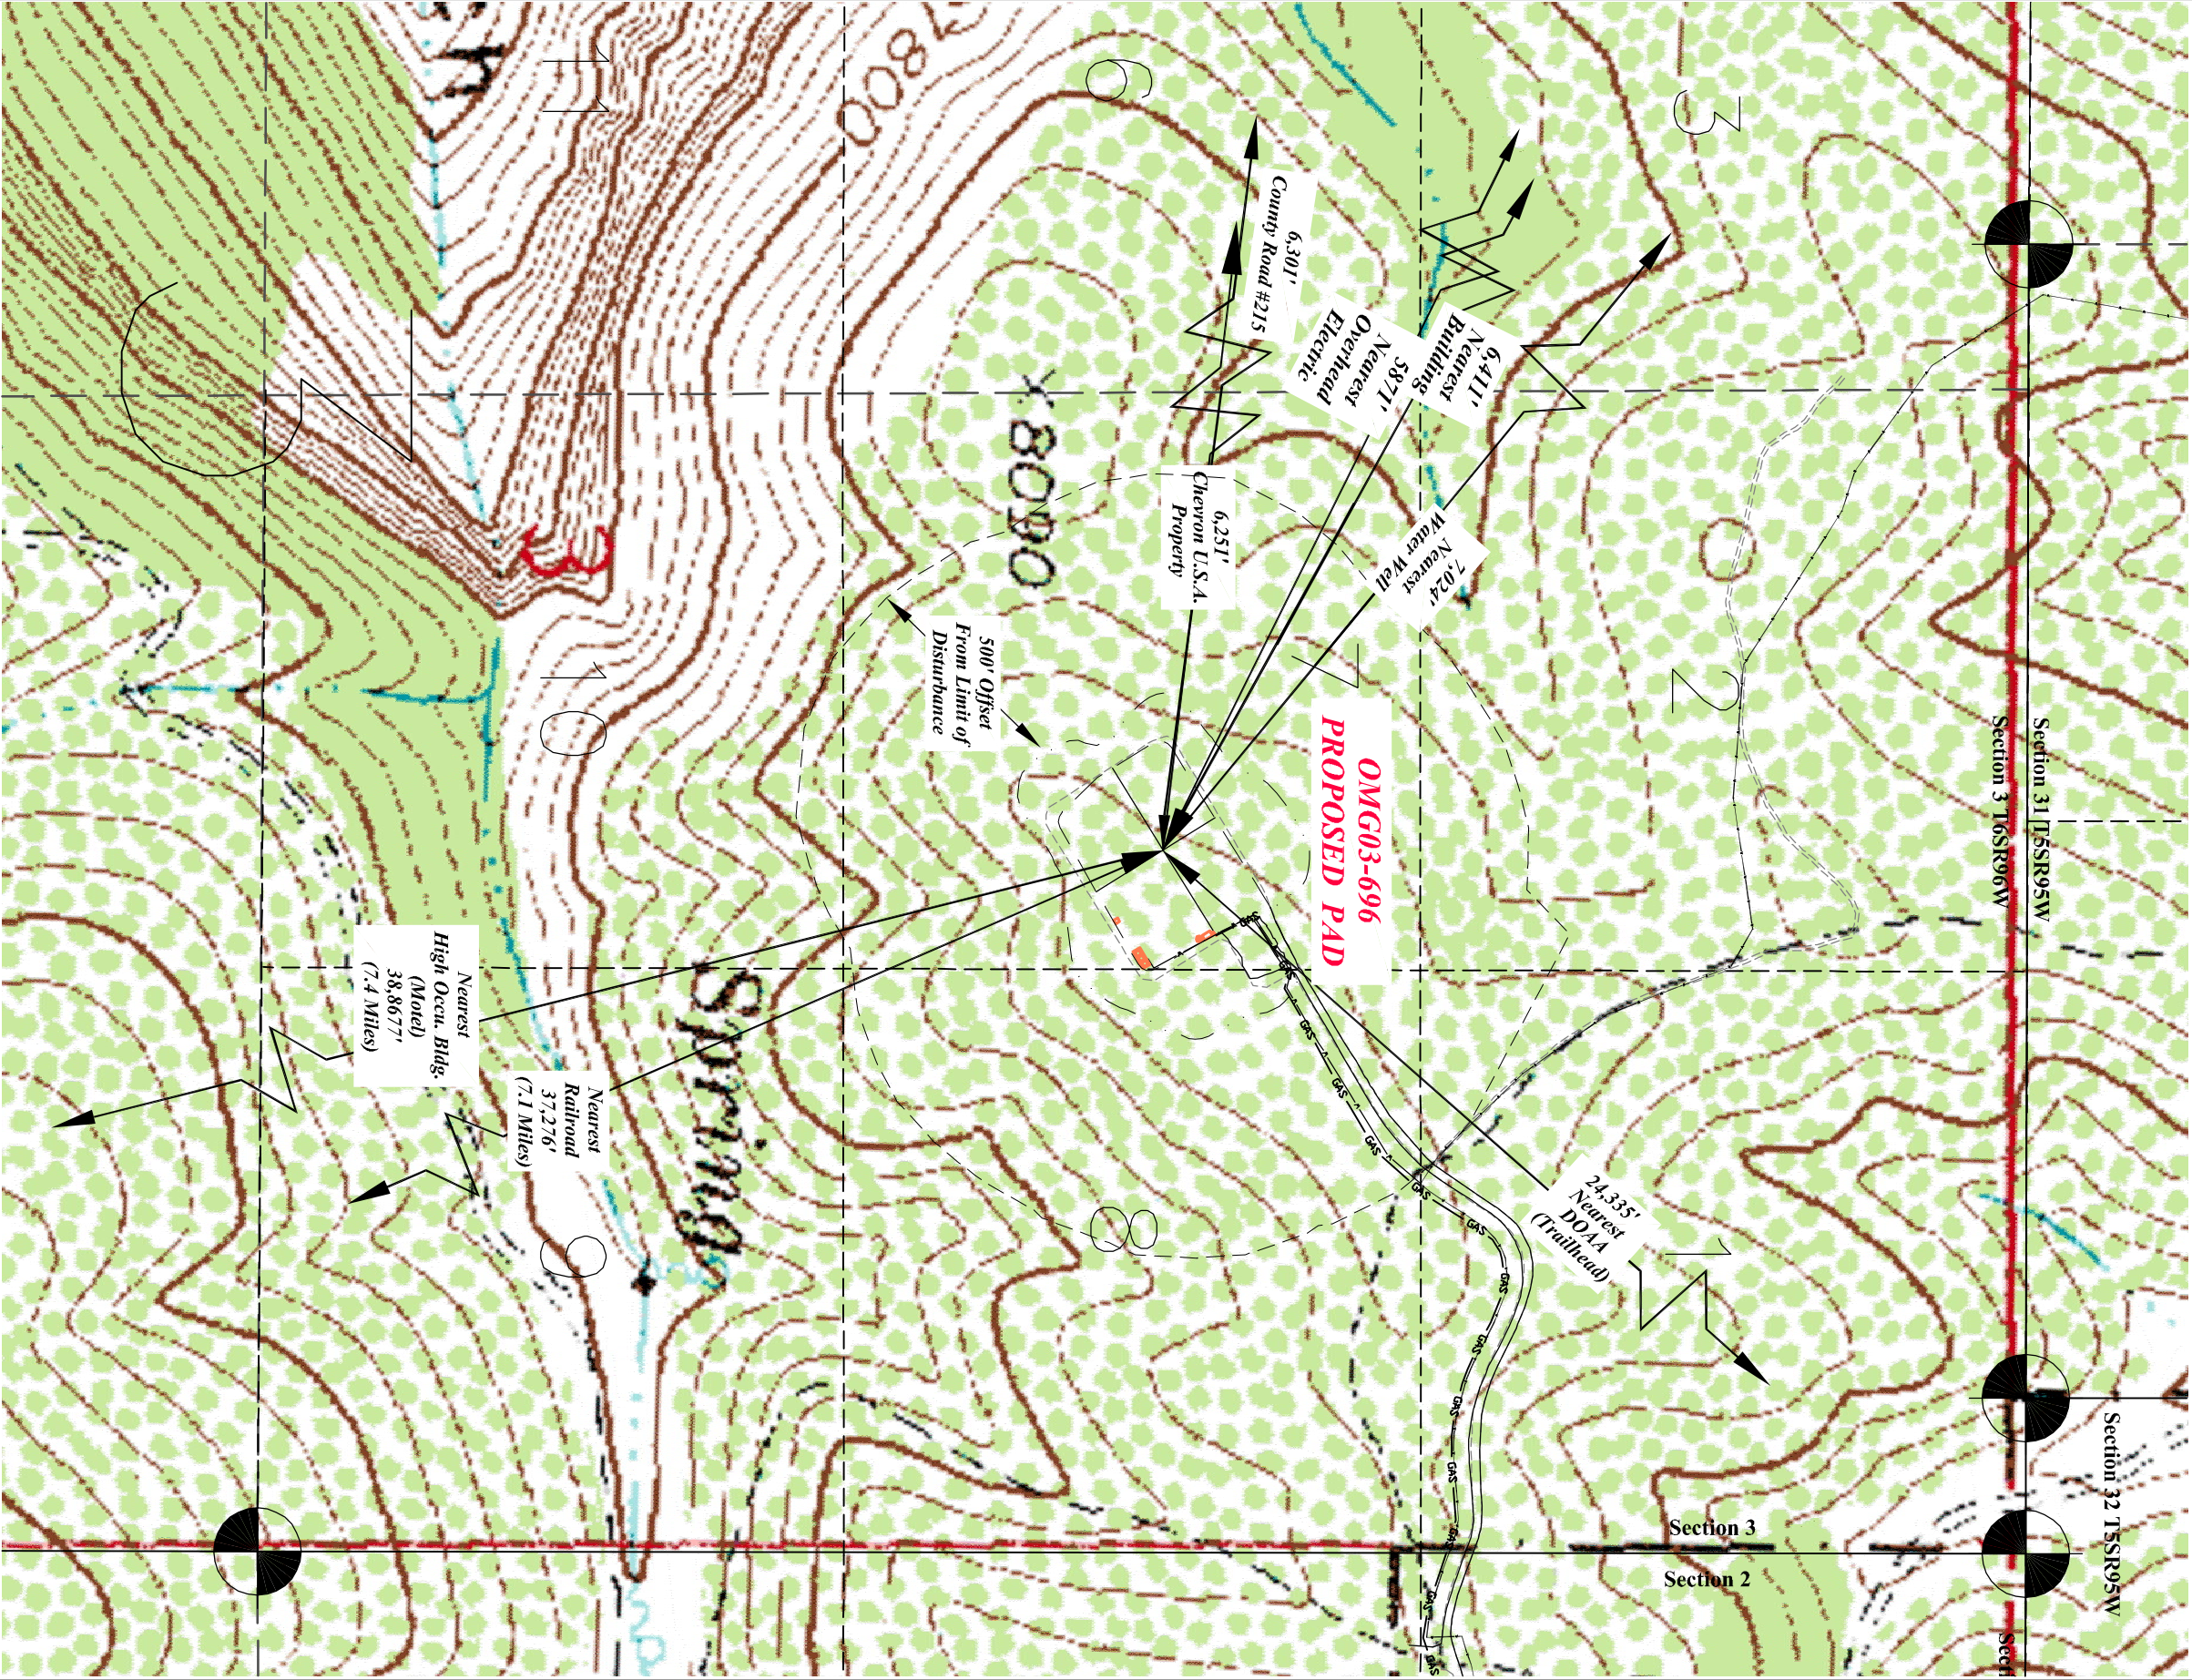

GRAPHIC SCALE

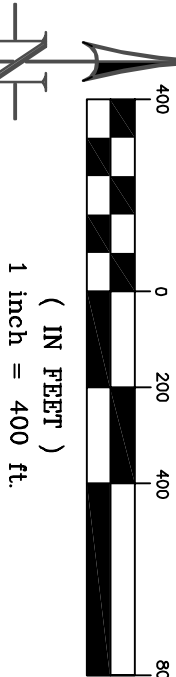

*Note: All measurements shown
are from Center of OMG03-696 Pad:*

NAD27 Lat. = 39.557646°

Long = -108.091129°

NAD83 Lat. = 39.557624°

Long = -108.091762°

Old Mountain G03-696

Lot 7 Section 03

T. 6 S., R. 96 W., 6TH PM

Garfield County, CO

Current Footage



**Berry
Petroleum
Company, LLC**

Stans to Stones Surveying LLC
559 Pine Meadow Dr.
Grand Junction, CO 81504
(970) 618-2118

SURVEY BY: IM 12/21/17

PDOP: 2.0

DRAWN BY: IM 02/23/18

DWG: OMG03-696

REVISION:

Pad Elevation = 8168.5