


# Well Location Certificate

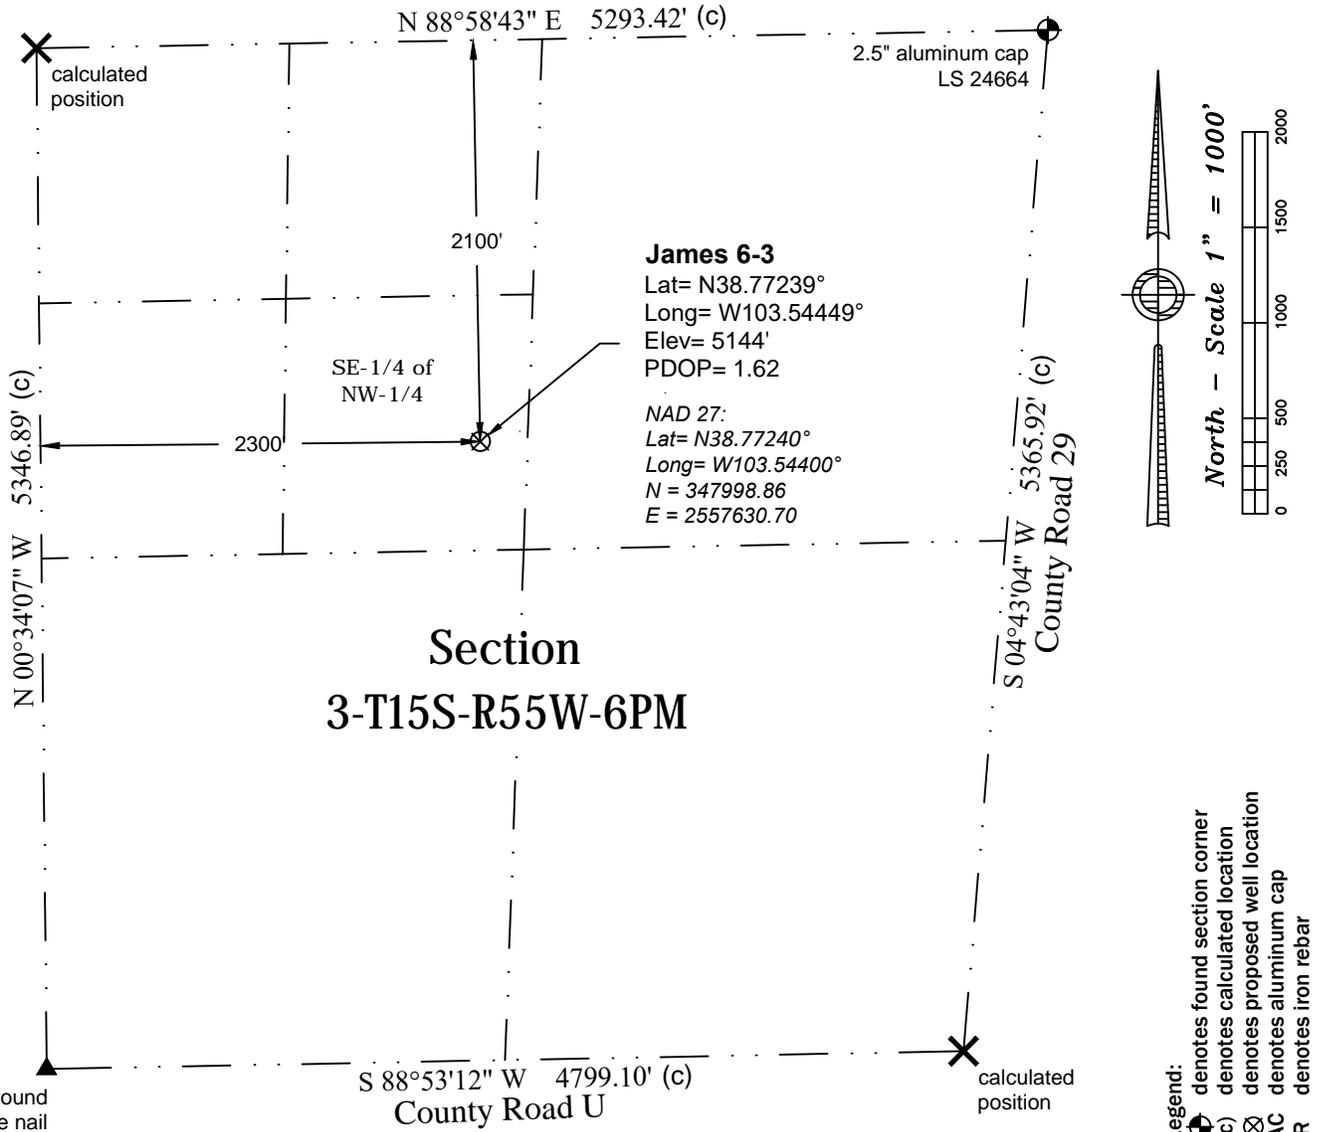

- Notes:
- In accordance with a request from K3 Oil & Gas Operating Company, PLS Group has determined the location of the James 6-3 well to be 2300' FWL and 2100' FNL as measured perpendicular to the section lines.
  - Coordinates and bearings based NAD 83, Colorado State Plane Coordinates
    - Central Zone (SPC) using RTK GPS observations taken on 7.20.2017 by Craig Burke.
    - Elevations based on NAVD 88 Datum using GPS observed heights and Geoid 12A corrections.
    - Distances shown are in SPC grid feet. Ground scale factor= 1.000289187932.
    - This is not a Land Boundary Survey.
    - No rights of way or easements shown at client's request.
    - There are no improvements within 200' of the proposed well site.
    - Apparent Land Use is range land.
    - Vegetation is native grass.

**Surveyor's Statement**  
 I, M. Bryan Short, hereby state that this exhibit is the result of a field survey made under my supervision and based upon my information and knowledge, I believe this exhibit to be a true and correct representation of said survey.



Well Name: <b style="font-size: 1.2em;">James 6-3</b>	Field Date <b>7.20.2017</b>	Prepared for: <b style="font-size: 1.2em;">K3 Oil &amp; Gas Operating Company</b>
Section 3-T15S-R55W-6th PM, SE-NW	Party Chief <b>DCB</b>	<b>PLS Group</b> 6843 North Franklin Avenue Loveland, Colorado 80538 970.669.2100 office - 970.669.3652 fax
Lincoln County, Colorado	Proj. Manager <b>ZNB</b>	
	Drawing Date <b>7.25.2017</b>	