00270758

CERTIFICATE OF SURVEY
for
Dakota Energy and Resources
Weld County, Colorado

RECEIVED
JUN 17 1988
COLO. OIL & GAS CONS. COMM.

T9N R57W 6PM.

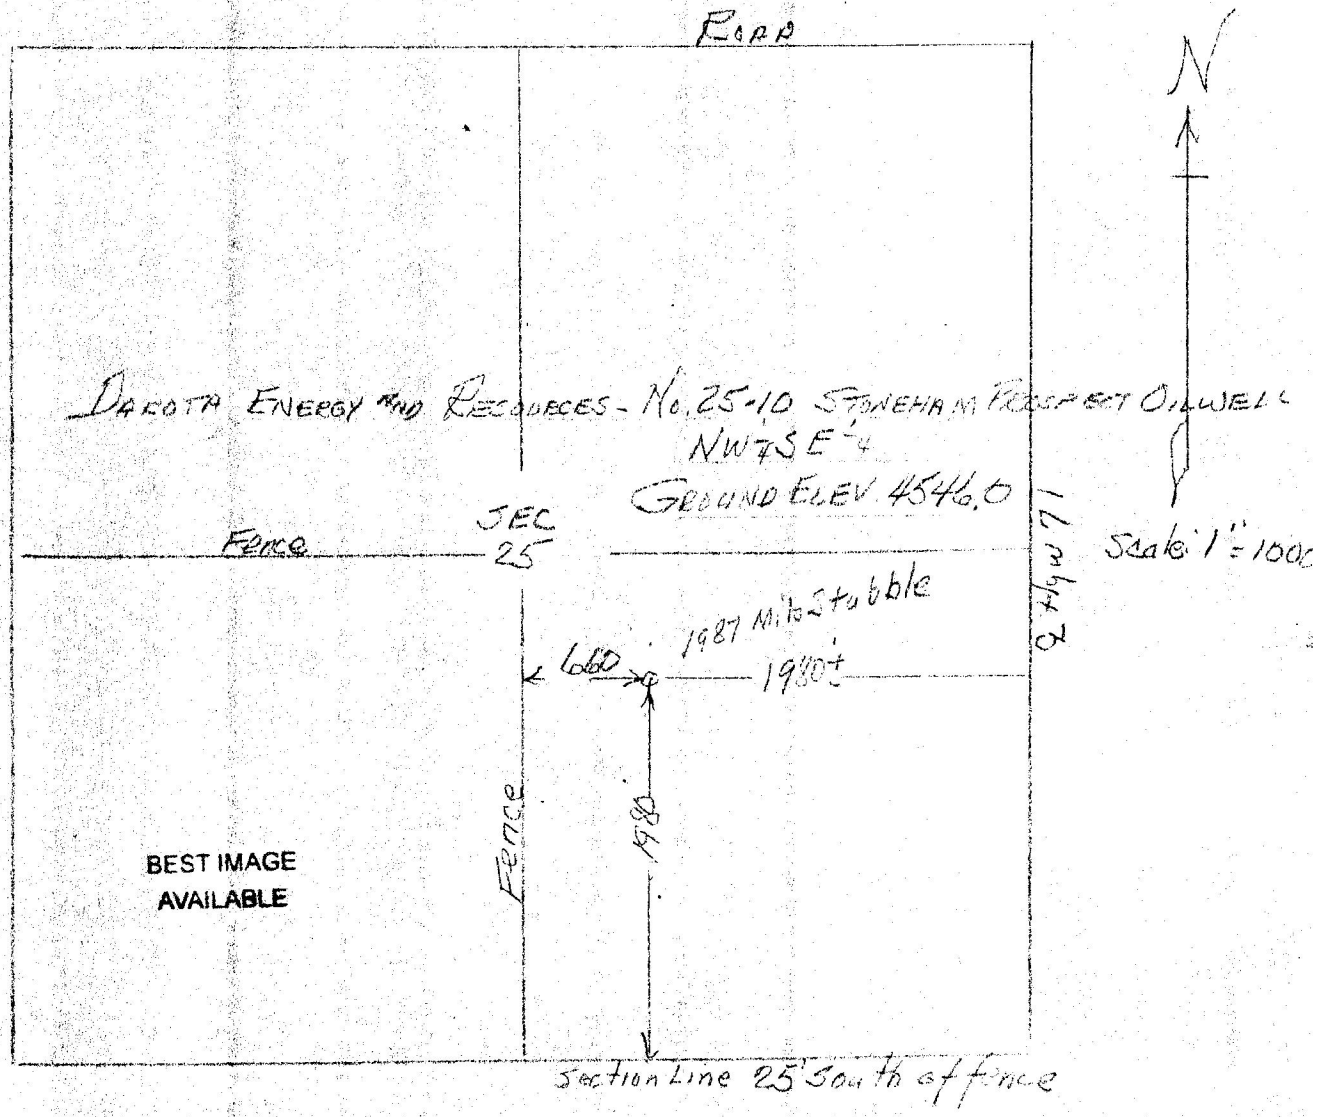

I hereby certify that the above plat is an accurate representation of a correct survey showing the location of Dakota Energy and Resources -No.25-10 Stoneham Prospect Oilwell in NW¼SE¼ Sec. 25 T9N R57W 6PM. The elevation of the ground at the stake is 4546.0 feet above sea level from U.S.G.S. Bench Mark.

Fort Morgan, Colorado
May 7, 1988

Registered Professional Engineer
State of Colorado