




CERTIFICATE OF SURVEY
for
Patrick A. Doherty
Logan County, Colorado

RECEIVED
NOV 27 1964

OIL & GAS
CONSERVATION COMMISSION

T10N R53W 6PM

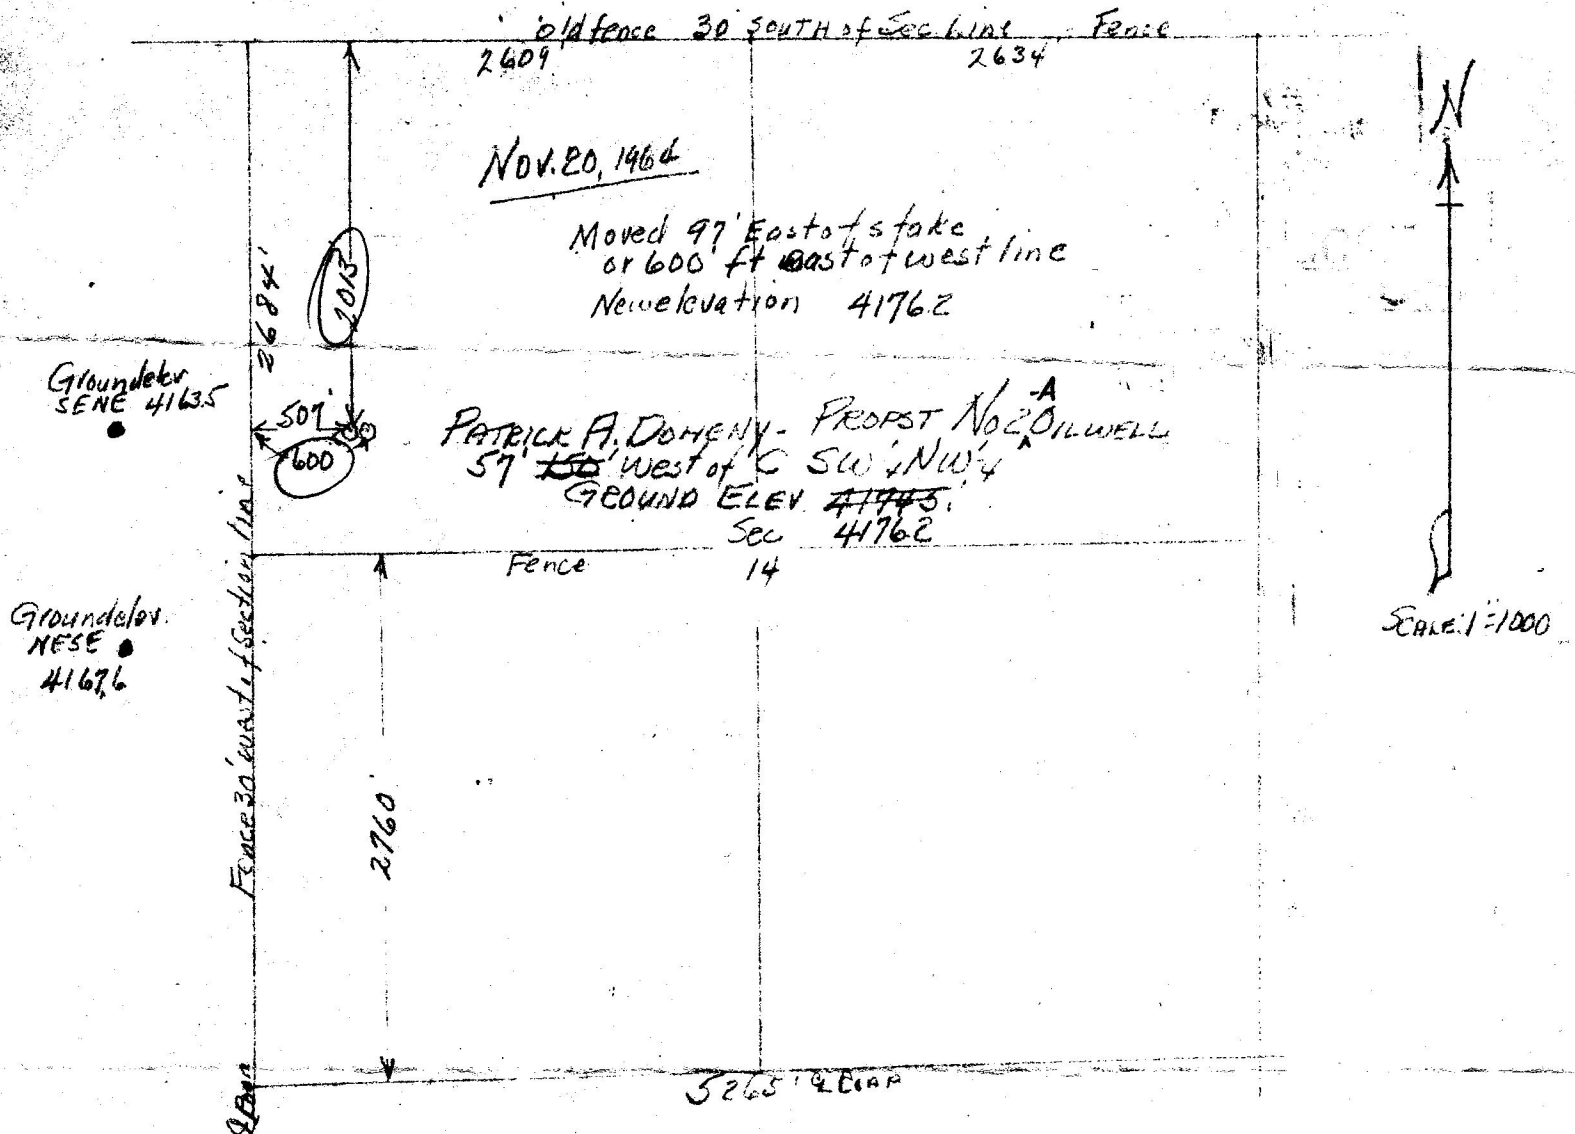

I hereby certify that the above plat is an accurate representation of a correct survey showing the location of Patrick A. Doherty - Propst No. 2 Oilwell ~~150~~ feet west of Center SW 1/4 NW 1/4 Sec. 14 T10N R53W 6PM. The elevation of the ground at the stake is ~~4174.5~~ feet above sea level from U.S.G.S. Bench Mark. 4176.2

Fert Morgan, Colorado
Nov. 15, 1964

Registered Professional Engineer
State of Colorado.

Nov. 20, 1964

The stake was moved 93 feet east from the original set making the distance from the west sec. line 600 feet. The new elevation is 4176.2