





CERTIFICATE OF SURVEY  
for  
Patrick A. Deheny  
Logan County, Colorado

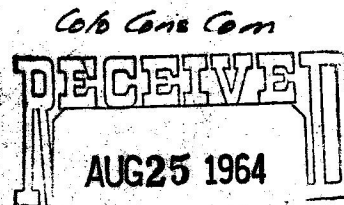

OIL & GAS  
CONSERVATION COMMISSION

TION R53W6PM.

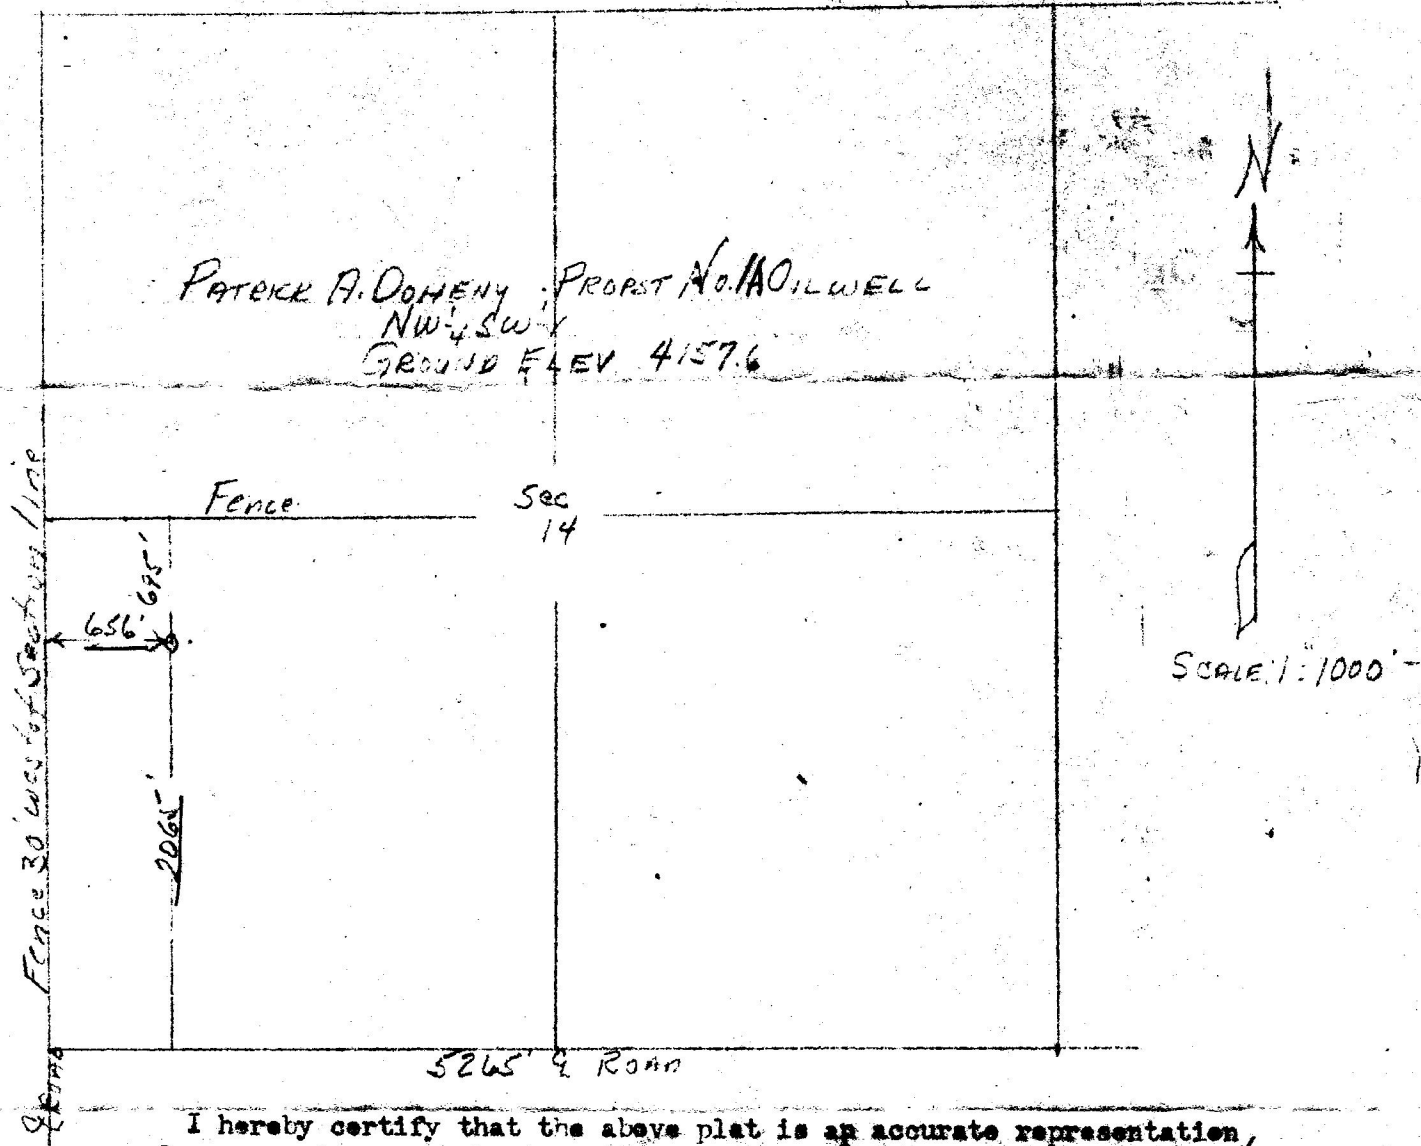

I hereby certify that the above plat is an accurate representation of a correct survey showing the location of Patrick A. Deheny- Propst #1A Oilwell in NW 1/4 SW 1/4 Sec. 14 TION R53W 6PM. The elevation of the ground at the stake is 4157.6 feet above sea level from U.S.C.S. Bench Mark.

Fert Morgan, Colorado  
Aug. 20, 1964

*Cecil J. Osborne*  
Registered Professional Engineer  
State of Colorado

64-375