




CERTIFICATE OF SURVEY
for
Exeter Drilling Co.
Logan County, Colorado

RECEIVED
NOV 18 1964

OIL & GAS
CONSERVATION COMMISSION

TION E52W6PM

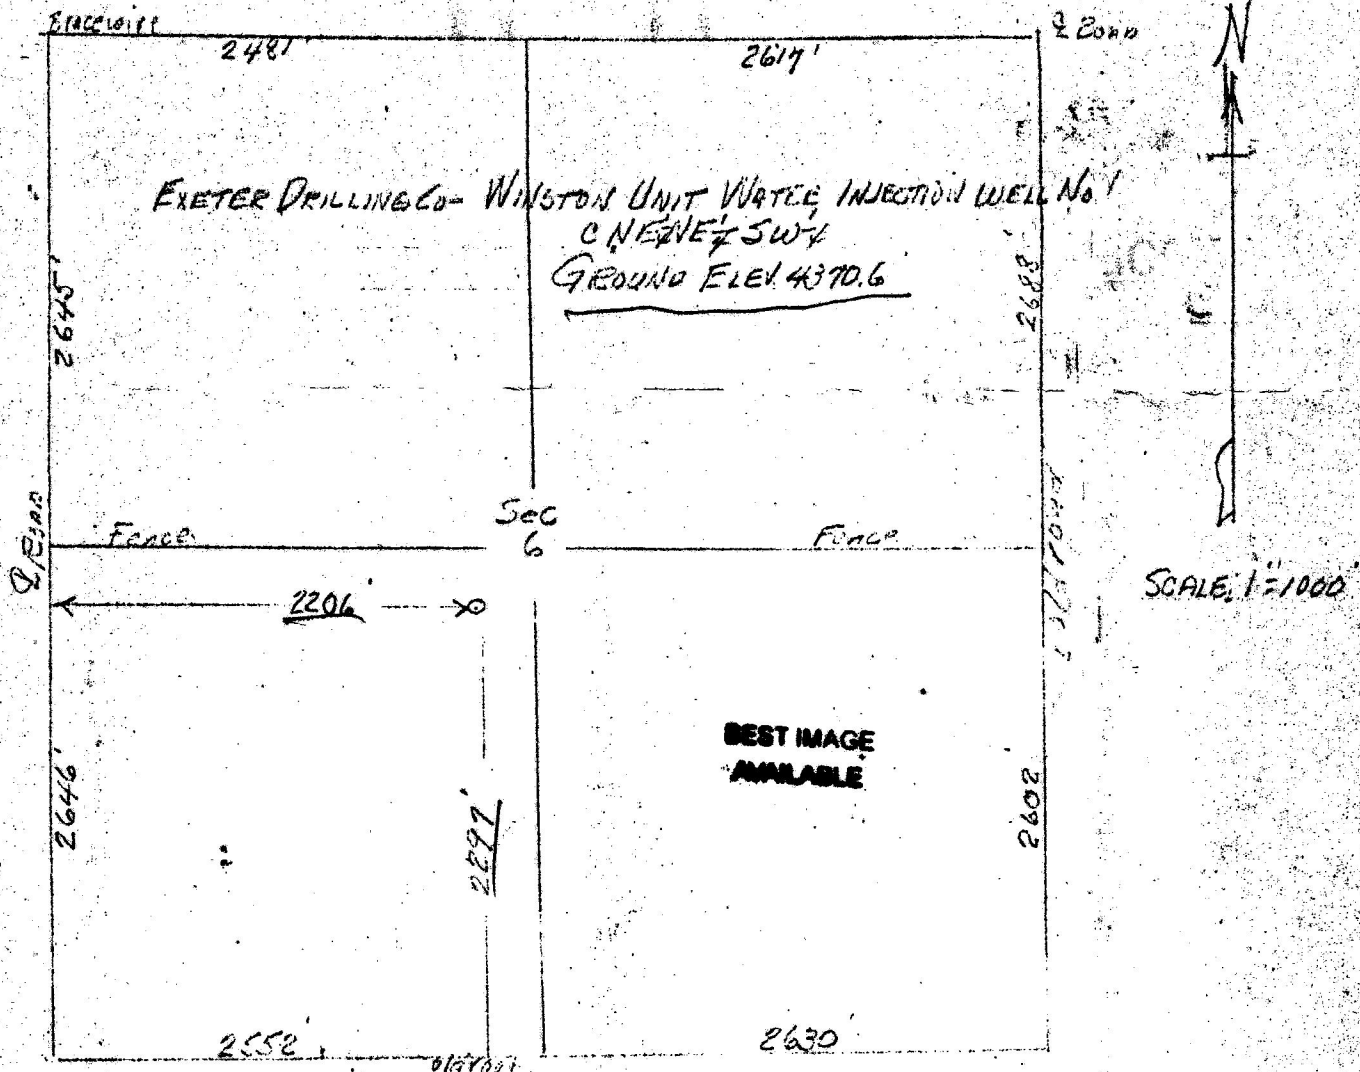

I hereby certify that the above plat is a true and correct representation of a survey showing the location of Exeter Drilling Co.- Winston Unit Water Injection Well No. 1 C NE 1/4 SW 1/4 S-c. 6 TION R52W (PM). The elevation of the ground at the stake is 4370.6 feet above sea level from U.S.C. & G. Bench Mark.

Fort Morgan, Colorado
Nov. 10, 1964

Laurel A. Colone
Registered Professional Engineer
State of Colorado

Exeter 6-10N-5E