



CERTIFICATE OF SURVEY
for
Patrick A. Doheny
Logan County, Colorado


Colo Cons Com

RECEIVED
MAR 16 1966

OIL & GAS
CONSERVATION COMMISSION

T10N R53W 6PM

Old fence 30' South of Section

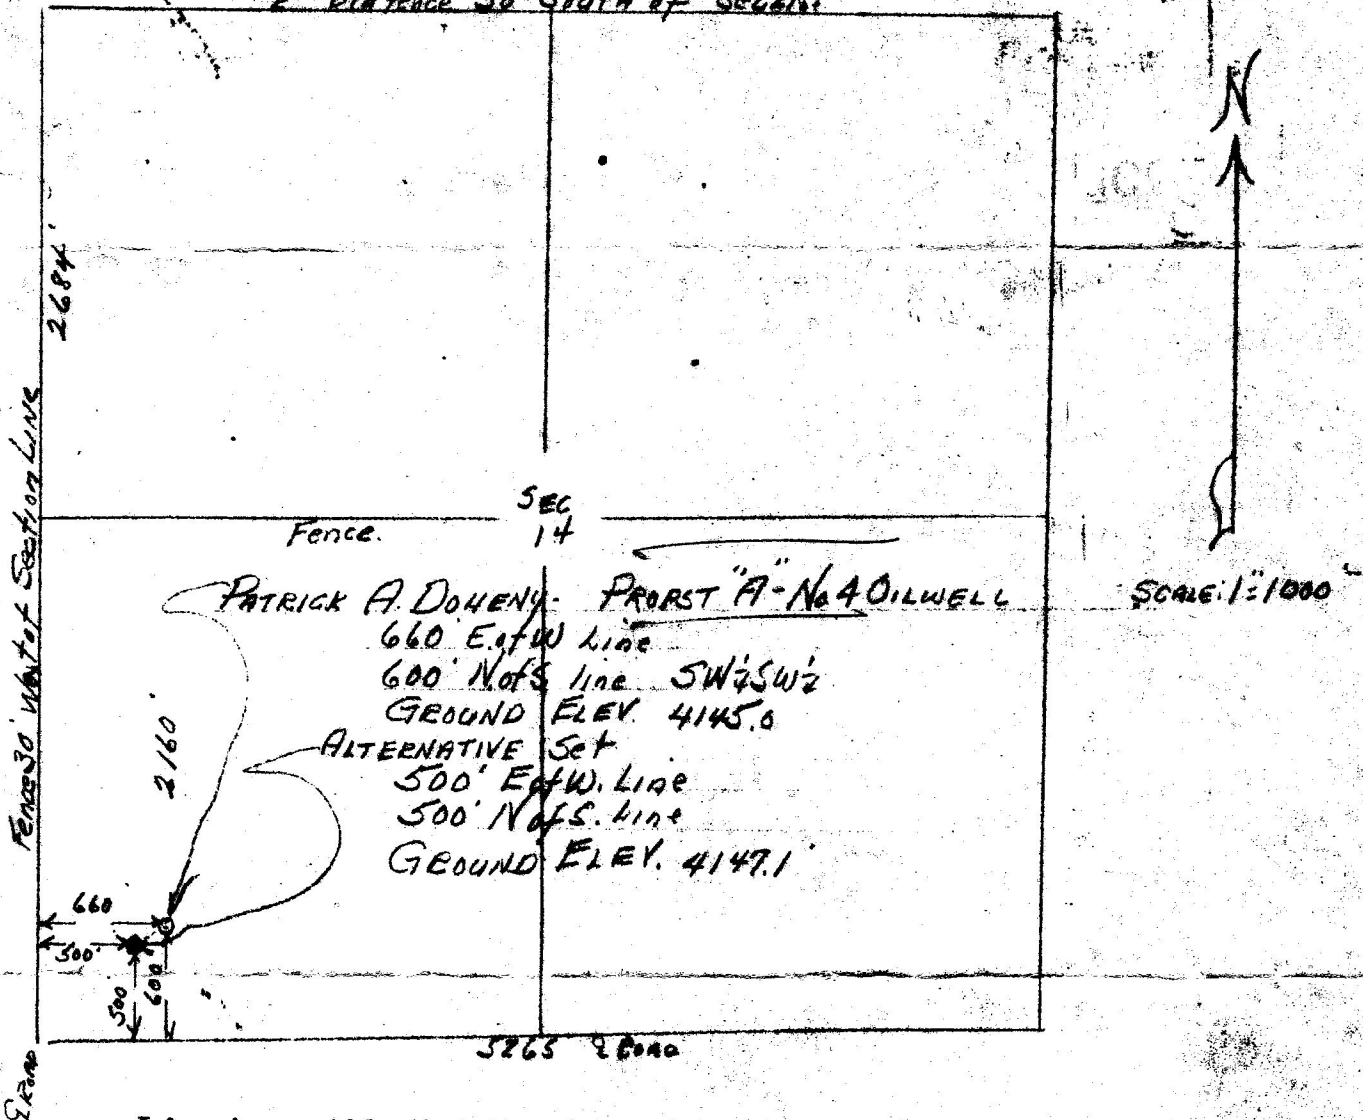

I hereby certify that the above plat is an accurate representation of a correct survey showing the location of Patrick A. Doheny-Probst No. 4 Oilwell in SW 1/4 Sec. 14, T10N R53W 6PM. The elevation of the ground at the stake is shown above for alternative locations.

Fort Morgan, Colorado
March 11, 1966

Bevil R. Osborne
Registered Professional Engineer
State of Colorado

66 79

14-10N-53W