


Well/Facility:	Ivers-Minch-Weber #1	Well Status:	Current
Operator:	Magpie Operating Inc	Formation:	CDL / Nio
Lease/Op Agmt:		Prod Interval:	
Field:	Johnson's Corner	API #:	05-069-06325
County:	Larimer	GR/KB:	
State:	CO	TD:	4,780'
Spud:	2/20/1994	PBTD:	4,772'
Comp. Date:	3/30/1994	WI:	100.00000%
1st Prod:	5/30/1994	NRI:	
Xmas tree:			
Surface Loc:	1530 FNL 155 FEL		
Sec-Twn-Rge:	SENE 30 5N68W		
Comments:	Current Well Diagram		

Date Drawn: Mar-27-2018

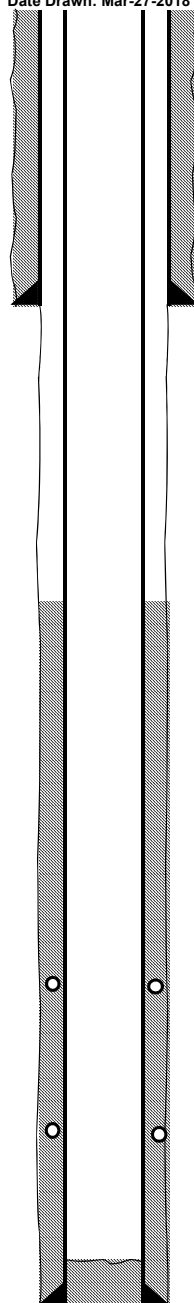

Hole Size
12-1/4"

Surface Csg @ 210'
8-5/8", 24#
Cement to surface 200 sx

Hole Size
7-7/8"
TD 4780'

No tubing in the hole.

Perfs - Niobrara
4374-4400' 4 spf 105 holes
4569-4606' 2 spf 75 holes

Perfs - Codell
4676-4690'
4 SPF, 56 Shots
Frac 1500 gal 7.5% HCl
1640 bbl KCl gel fluid and 220,000# 20/40 sand

Gologic Markers		
MD		
757	Parkman	
1,396	Sussex	
1,790	Shannon	
4,355	Niobrara	
4,653	Timpas	
4,674	Codell	

Prod Csg @ 4,784'
5-1/2", 15.5#
550 sx cement TOC = 2,600' (State and CBL)