


**SCHRADER #J-15**  
Current Wellbore Diagram

API: 05-075-05069	State: Colorado	County: Logan
Location: NE SE 20-6N-54W	Operator: State of Colorado	
Ground Elevation (ft): 4,261	KB (ft): N/A	

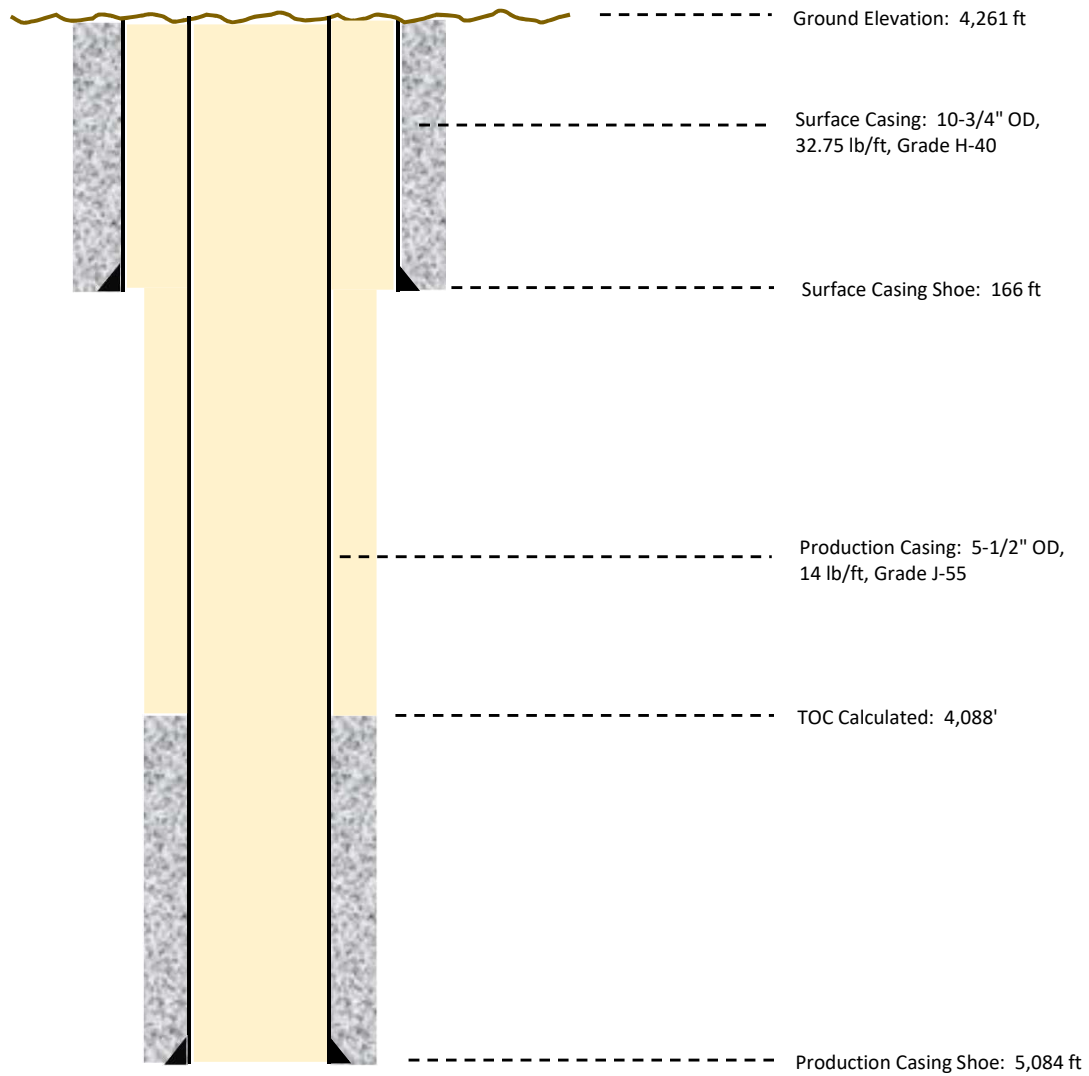

 - Existing Cement