



STATE #B-1
Current Wellbore Diagram

API: 05-075-05083	State: Colorado	County: Logan
Location: SE NW 21-6N-54W	Operator: State of Colorado	
Ground Elevation (ft): 4,206	KB (ft): 4,216	

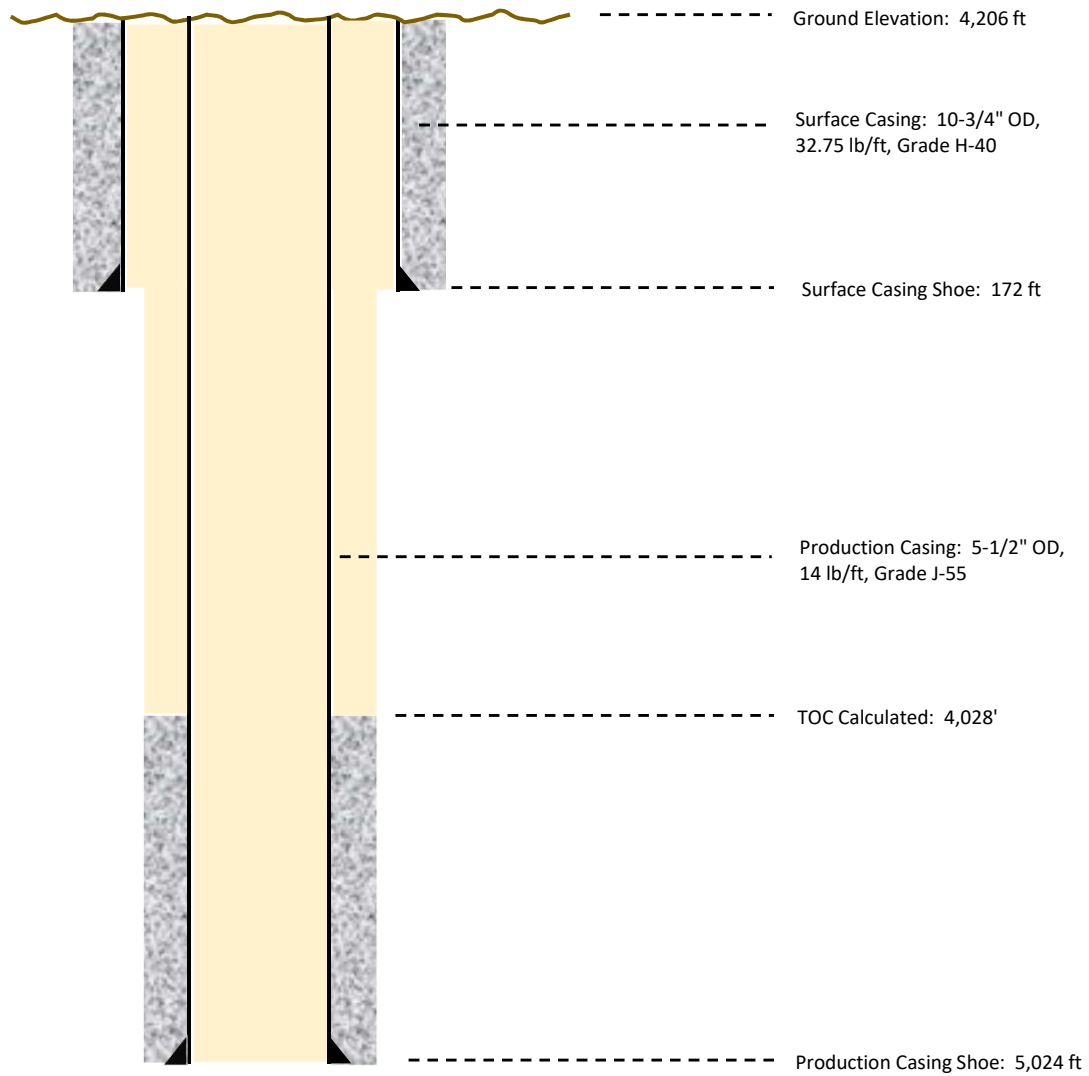

 - Existing Cement