


WELL LOCATION CERTIFICATE

THIS MAP DOES NOT REPRESENT A BOUNDARY SURVEY

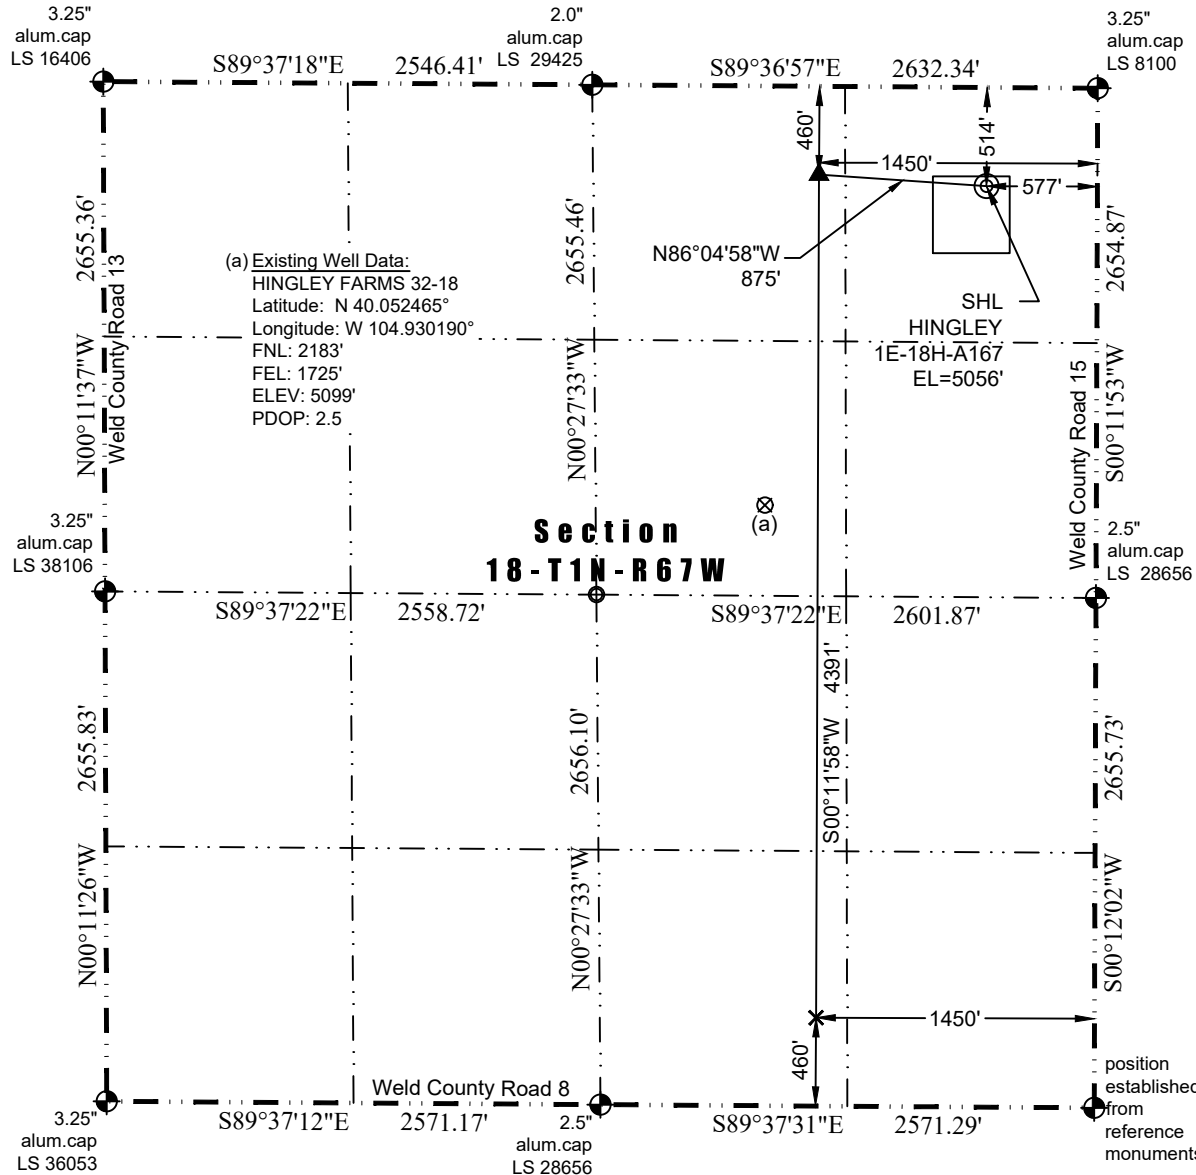

In accordance with a request from Jay Knutson of Crestone Peak Resources, Washburn Land Surveying, LLC has determined the location of the **Hingley 1E-18H-A167** well site to be SHL: 514' FNL and 577' FEL, (TPZ: 460' FNL and 1450' FEL, BHL: 460' FNL and 1450' FEL), as measured at ninety (90) degrees from the section lines of Section 18, Township 1 North, Range 67 West of the 6th Principal Meridian, Weld County Colorado.

Proposed Surface Hole Data:

Latitude: N 40.057007°
 Longitude: W 104.926029°
 PDOP: 1.3

Proposed TPZ Data:

Latitude: N 40.057186°
 Longitude: W 104.929145°

Proposed Bottom Hole Data:

Latitude: N 40.045133°
 Longitude: W 104.929301°

Nearest Cultural Items:

Building: 1307' southeast
 Building Unit: 2495' southeast
 Public Road: 567' east
 Property Line: 514' north
 Existing Well: 2023' southwest (Hingley Farms 32-18)

Above Ground Utility: 400' north
 Well Window: SHL is 51' inside
 Railroad: +5280'
 High Occupancy Building Unit: +5280'
 Designated Outside Activity Area: +5280'

LEGEND

- ⊕ - Found Survey Monument
- ⊙ - Calculated Location
- ⊙ - Surface Hole Location (SHL)
- ▲ - Top of Production Zone (TPZ)
- ✕ - Bottom Hole Location (BHL)

I hereby certify that this Well Location Certificate was prepared by me or under my direct supervision on 1/28/2018 for and on behalf of Crestone Peak Resources that it is not a Land Survey Plat or an Improvement Survey Plat and that it is not to be relied upon for establishment of fences, buildings, or other future improvement lines.

1-28-2018
 John Robert McGehee, Surveyor
 Well: Hingley 1E-18H-A167 WLC

Notes:

- 1) Bearings and distances based on NAD 83 Colorado North State Plane Coordinate, using RTK GPS observations taken 10/31/17 by operator Jason Dahlman
- 2) Conversion factor to ground (1.0002768105).
- 3) Elevations based on NAVD 88 GPS heights and Geoid 2009 corrections.
- 4) See Location Drawing for visible improvements within 500 feet of Pad Site.
- 5) The surface use is a cultivated field.

NOTICE: According to Colorado law you must commence any legal action based upon any defect in this W.L.C. within three years after you first discover such defect. In no event may any action based upon any defect in this W.L.C. be commenced more than ten years from this said date of the certification shown hereon.