Schematic - Actual

Well Name: Richter 44-27 **TD: 7,309.0**

API	Surface Legal Location	Field Name	State
05123230920000	SESE 27 7N 64W	Wattenberg	CO
Well Configuration Type	**Ground Elevation (ft)**	**Original KB Elevation (ft)**	**KB-Ground Distance (ft)**
Vertical	4,870.00	4,880.00	10.00

Most Recent Job

Job Category	Primary Job Type	Secondary Job Type	Start Date	End Date
Other	Wireline		12/22/2016	12/22/2016
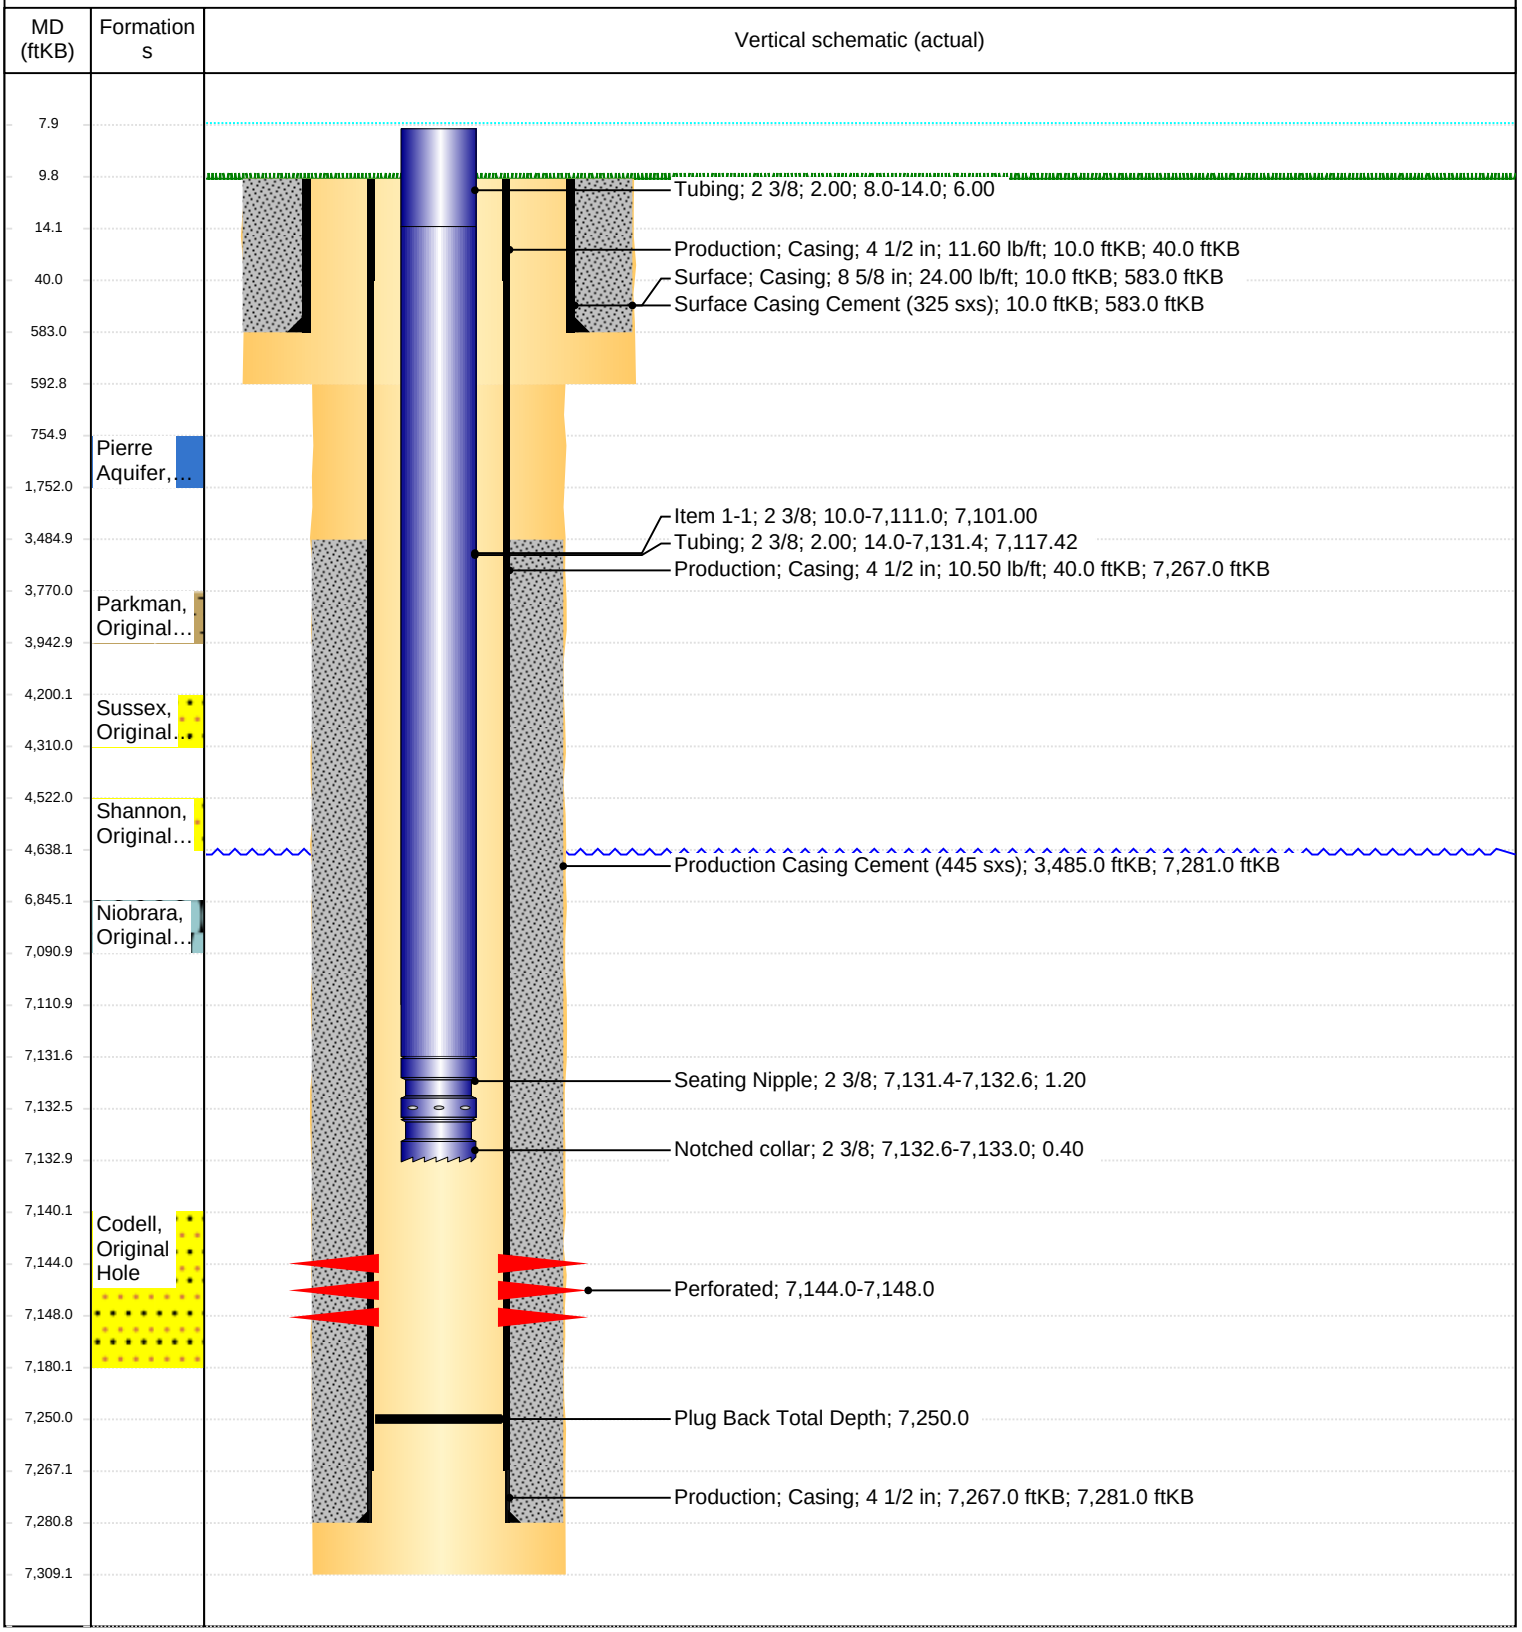
Vertical - Original Hole, 4/3/2018 3:21:28 PM