


Well/Facility:	Coulson #1	Well Status:	P&A
Operator:	Magpie Operating Inc	Formation:	NBCD
Lease/Op Agmt:		Prod Interval:	
Field:	Loveland	API #:	05-069-06191
County:	Larimer	GR/KB:	4,897' GR
State:	CO	TD:	4,872'
Spud:	7/2/1983	PBTD:	4,836'
Comp. Date:	9/1/1983	WI:	
1st Prod:		NRI:	
Xmas tree:			
Surface Loc:	1915 FSL 660 FEL		
Sec-Twn-Rge:	NESE 19 5N58W		
Comments:	FINAL ABANDONMENT DIAGRAM		

Date Drawn: Apr-2-2018

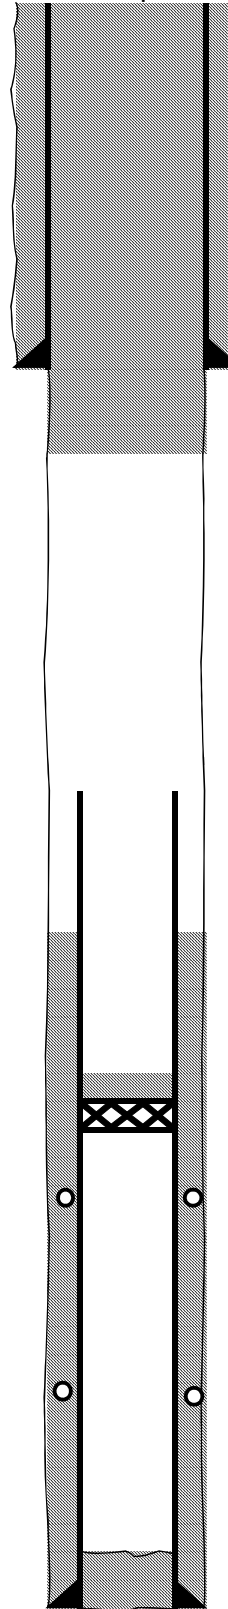

Cut & Weld on cap 4' below ground level

Hole Size
12-1/4"

Surface Csg @ 210'
8-5/8", 24#
Cement to surface 160 sx

110 sx cement from 270' to surface

Hole Size
7-7/8"
TD 4,872'

Casing cut and pulled at 3,131'

TOC @ 4,128'

No tubing in the hole.

CIBP @ 4,386' w/ 2 sx cement

Niobrara Perfs
4,436' - 4,671'
63 total holes

Codell Perfs
4,764' - 4,774'
21 total holes

Prod Csg @ 4,872'
4-1/2", 10.5#
200 sx cement

Gologic Markers		
MD		
825	Parkman	
1,475	Sussex	
1,875	Shannon	
4,435	Niobrara	
4,740	Timpas	
4,760	Codell	