


Well Name: DARYL L ARNOLD 1


VERTICAL - Original Hole, 4/5/2018 3:05:28 PM

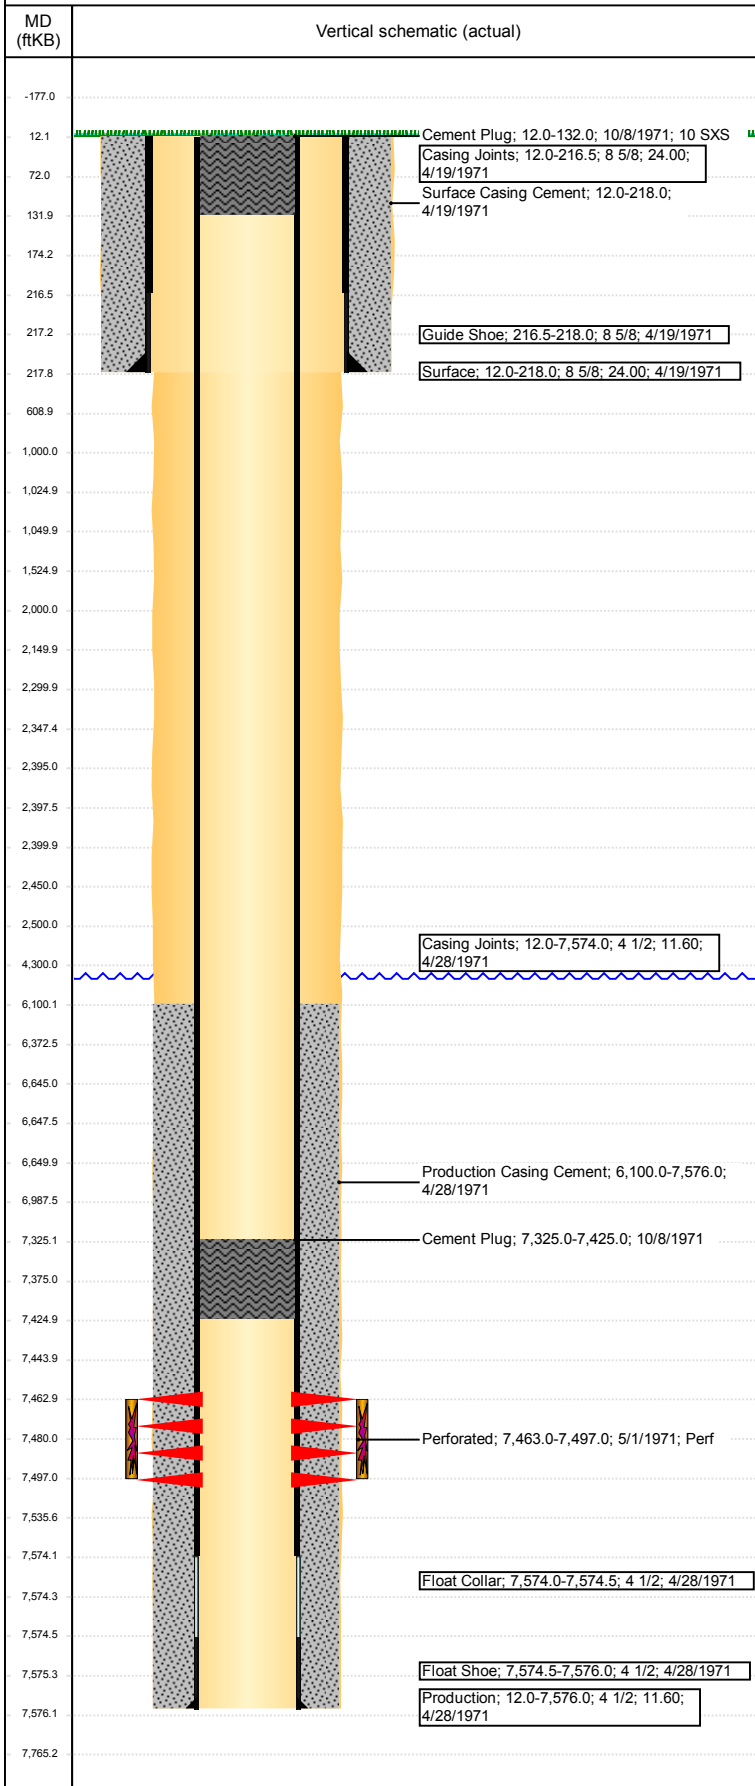

Well Header							
API 05-123-07299		Well Report Center			Well Configuration Type VERTICAL		
Original KB Elevation (ft) 4,915		KB - GL / MSL (ftKB) 12.00		Spud Date 4/19/1971		P & A Date 10/8/1971	
Production Route			Well Production Status DA				SoRT Ignore Yes
Directions To Well					Actual Latitude (°) 40.14278900	Actual Longitude (°) -104.50344100	
Comment							
Congressional Location							
Quarter 3	Quarter 4	Section	Township	Twntshp N/S Dir	Range	Range E/W Dir	
Rig Operator							
Rig Operator							
Plug Back Total Depths							
Date	Depth (ftKB)	Method			Com		
Wellbore Sections							
Section Des		Size (in)		Act Top, MD (ftKB)		Act Btm, MD (ftKB)	
SURFACE		12 1/4		12		218	
PRODUCTION		7 7/8		218		7,576	
Zone Statuses							
Zone Name		Status Date			Status		
Casing Strings							
Surface, 218.0ftKB							
Casing Description	Run Date	OD (in)	Wt/Len (l...	Grade	Top, MD (ft...	MD (ftKB)	
Surface	4/19/1971	8 5/8	24.00		12.0	218.0	
Production, 7,576.0ftKB							
Casing Description	Run Date	OD (in)	Wt/Len (l...	Grade	Top, MD (ft...	MD (ftKB)	
Production	4/28/1971	4 1/2	11.60		12.0	7,576.0	
Cement							
Des			Start Date		Top (ftKB)		Btm (ftKB)
Surface Casing Cement			4/19/1971		12.0		218.0
Production Casing Cement			4/28/1971		6,100.0		7,576.0
Cement Plug			10/8/1971		12.0		132.0
Cement Plug			10/8/1971		7,325.0		7,425.0
Proposed Cement							
Des					Top (ftKB)		Btm (ftKB)
Cement Plug					7,325.0		7,425.0
Cement Plug					2,400.0		2,500.0
Cement Plug					12.0		1,000.0
Cement Plug					1,000.0		1,050.0
Cement Plug					2,000.0		2,500.0
Cement Plug					2,300.0		2,395.0
Tubing Strings							
Tubing Description	Run Date	String ...	ID (in)	Wt (lb/ft)	Grade	Len (ft)	Set De...
Other In Hole							
Run Date	Des			OD (in)	Top (ftKB)	Btm (ftKB)	
Proposed Other In Hole							
Des			OD (in)	Top (ftKB)		Btm (ftKB)	
Cast Iron Bridge Plug w/ 2 SX Cement			3.99	6,645.0		6,650.0	
Cement Retainer			3.99	2,395.0		2,400.0	
Logs							
Date	Type				Top, MD (ftKB)		Btm, MD (ftKB)
Perforation Data							
Linked Zone		Sum of Entered Shot Total	Top (ftKB)	Btm (ftKB)		Date	
J SAND, Original Hole		12	7,463.00	7,497.00		5/1/1971	
Total (Sum)		12					

Well Name: DARYL L ARNOLD 1

VERTICAL - Original Hole, 4/5/2018 3:05:29 PM

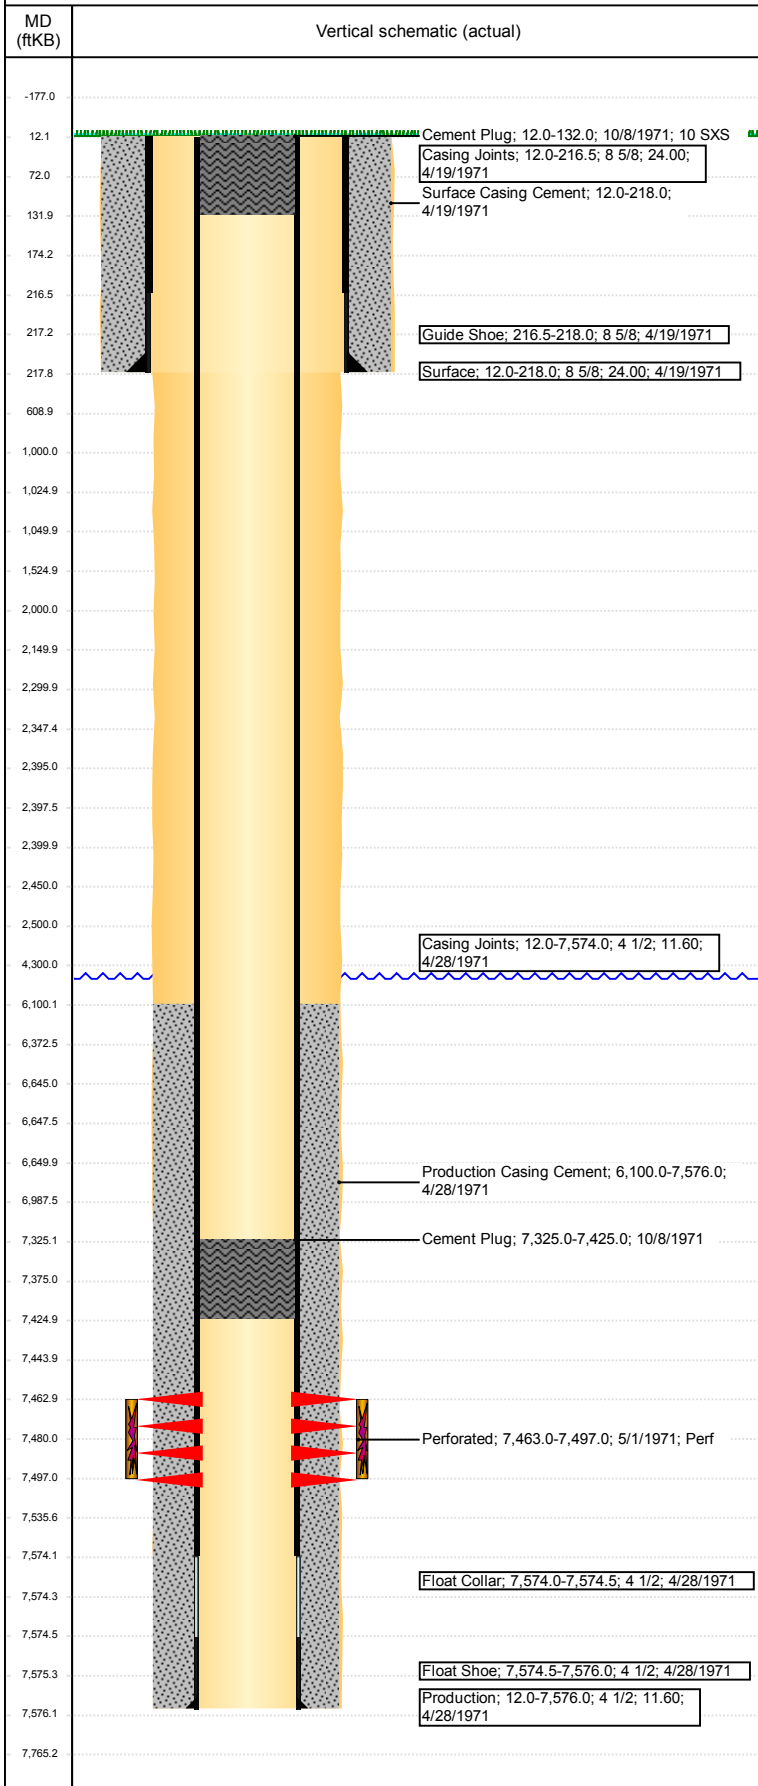

Proposed Perforations					
Linked Zone	Sum of En...	Top Depth (ftKB)	Btm (ftKB)	Date	
	0	2,500.00	2,500.00	2/16/2018	
Total (Sum)	0				
Job Supply Amounts					
Supply Item Des	Type	Uni...	Job Category	Total ...	Total ...
				Total ...	Total ...