


FINAL P&A WELLBORE DIAGRAM

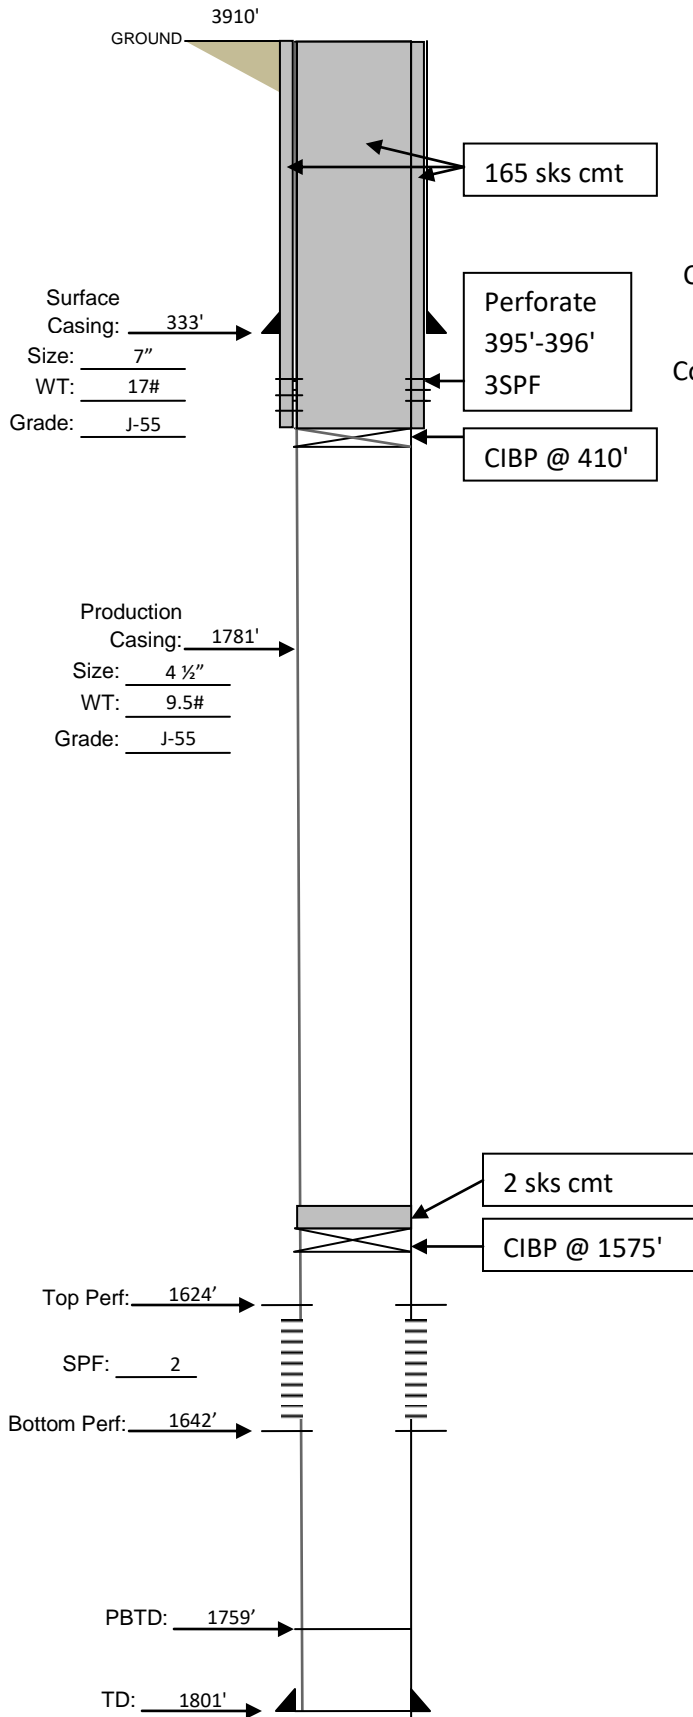

Well: OSMUS C4-24

API: 05-125-06593-00

Location: 1230' FSL & 1420' FEL, SWSE
Sec. 24, T4S-R44W; ELEV GL 3910'

County, State: Yuma, CO

Date: 03-31-2018

Co. Supervisor: Roelfs

Lat/Longs: 39.691573 / -102.2397