


# Wellbore Schematic Input Report

**Well Name: CHAMPLIN AMOCO A01 308**

VERTICAL - Original Hole, 4/11/2018 4:49:15 PM

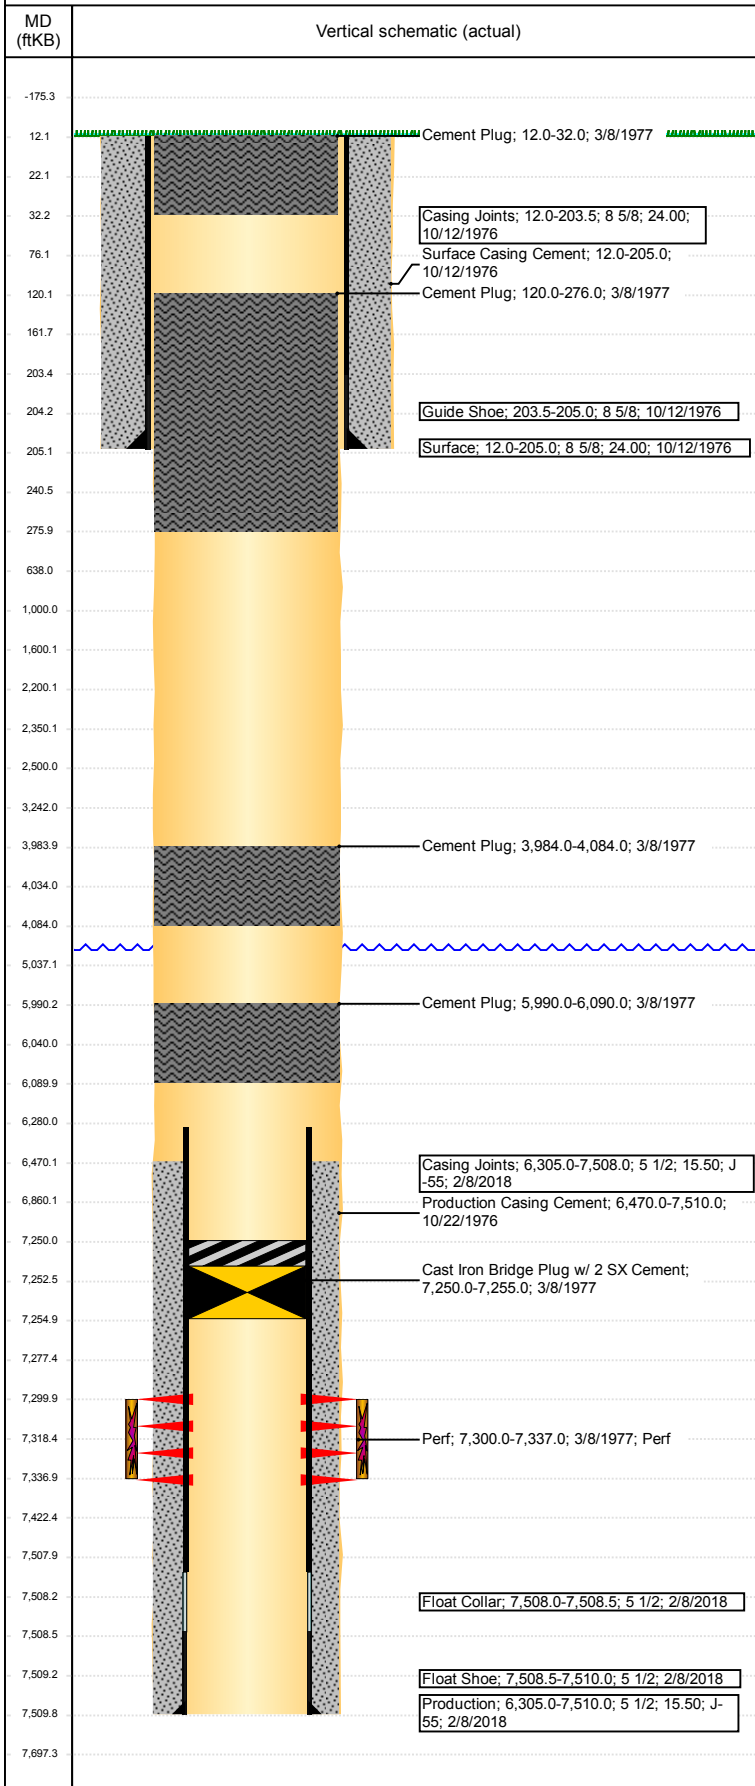

Well Header							
API 05-123-08968		Well Report Center			Well Configuration Type VERTICAL		
Original KB Elevation (ft) 4,671		KB - GL / MSL (ftKB) 12.00		Spud Date 10/12/1976		P & A Date	
Production Route				Well Production Status PA			SoRT Ignore Yes
Directions To Well				Actual Latitude (°) 40.46645500		Actual Longitude (°) -104.52109400	
Comment							
Congressional Location							
Quarter 3 SE	Quarter 4 SW	Section 23	Township	Twntshp N/S Dir	Range	Range E/W Dir	
Rig Operator							
Rig Operator							
Plug Back Total Depths							
Date	Depth (ftKB)	Method			Com		
Wellbore Sections							
Section Des		Size (in)		Act Top, MD (ftKB)		Act Btm, MD (ftKB)	
SURFACE		12 1/4		12		205	
PRODUCTION		7 7/8		205		7,510	
Zone Statuses							
Zone Name		Status Date			Status		
Casing Strings							
Surface, 205.0ftKB							
Casing Description Surface	Run Date 10/12/1976	OD (in) 8 5/8	Wt/Len (l... 24.00	Grade	Top, MD (ft... 12.0	MD (ftKB) 205.0	
Production, 7,510.0ftKB							
Casing Description Production	Run Date 2/8/2018	OD (in) 5 1/2	Wt/Len (l... 15.50	Grade J-55	Top, MD (ft... 12.0	MD (ftKB) 7,510.0	
Cement							
Des		Start Date		Top (ftKB)		Btm (ftKB)	
Surface Casing Cement		10/12/1976		12.0		205.0	
Production Casing Cement		10/22/1976		6,470.0		7,510.0	
Cement Plug		3/8/1977		5,990.0		6,090.0	
Cement Plug		3/8/1977		3,984.0		4,084.0	
Cement Plug		3/8/1977		120.0		276.0	
Cement Plug		3/8/1977		12.0		32.0	
Proposed Cement							
Des				Top (ftKB)		Btm (ftKB)	
Balance Plug				2,200.0		2,500.0	
Cement Plug				12.0		1,000.0	
Tubing Strings							
Tubing Description	Run Date	String...	ID (in)	Wt (lb/ft)	Grade	Len (ft)	Set De...
Other In Hole							
Run Date	Des			OD (in)	Top (ftKB)	Btm (ftKB)	
3/8/1977	Cast Iron Bridge Plug w/ 2 SX Cement			4.95	7,250.0	7,255.0	
Proposed Other In Hole							
Des			OD (in)	Top (ftKB)	Btm (ftKB)		
Logs							
Date	Type				Top, MD (ftKB)	Btm, MD (ftKB)	
Perforation Data							
Linked Zone	Sum of Entered Shot Total	Top (ftKB)	Btm (ftKB)		Date		
J SAND, Original Hole	0	7,300.00	7,337.00		3/8/1977		
Total (Sum)	0						
Job Supply Amounts							
Supply Item Des	Type	Uni...	Job Category		Total...	Total...	Total...