




**DRILLING COMPANY, INC.**  
**WICHITA, KANSAS**

**Current Wellbore Diagram**

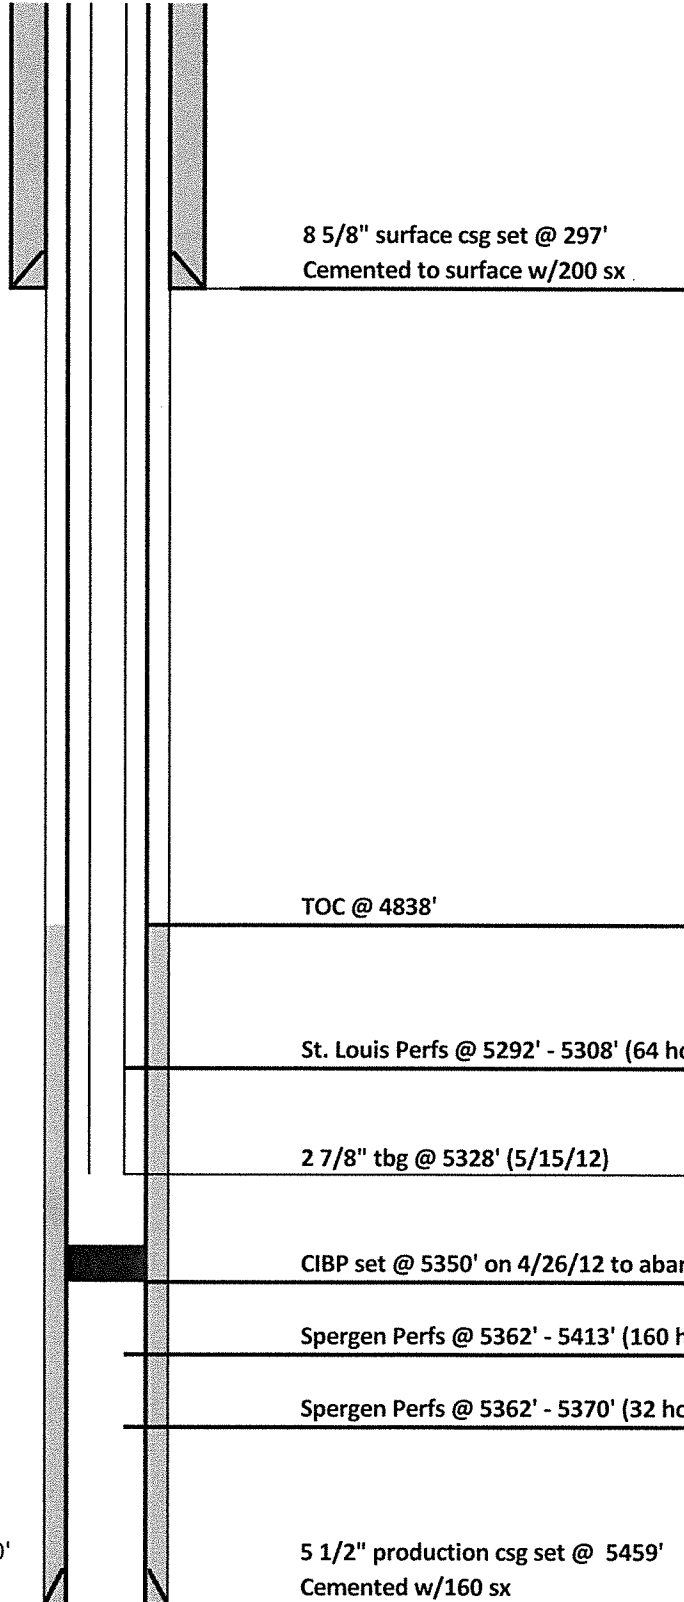

Date:	3/15/2016
Well Name:	Kern #1
Location:	1986' FNL & 1977' FEL
	SW/4 NE/4 28-13S-44W
County:	Cheyenne
State:	Colorado
API:	05-017-06134-00
GL:	4229'
KB:	4239'
Spud Date:	6/11/1991