


WELLBORE DIAGRAM  
 EXTRACTION OIL & GAS  
 Graeber 33-33DX  
 SENE 33 T1N R68W  
 WELD COUNTY  
 05-123-23837

Existing

Proposed Additions

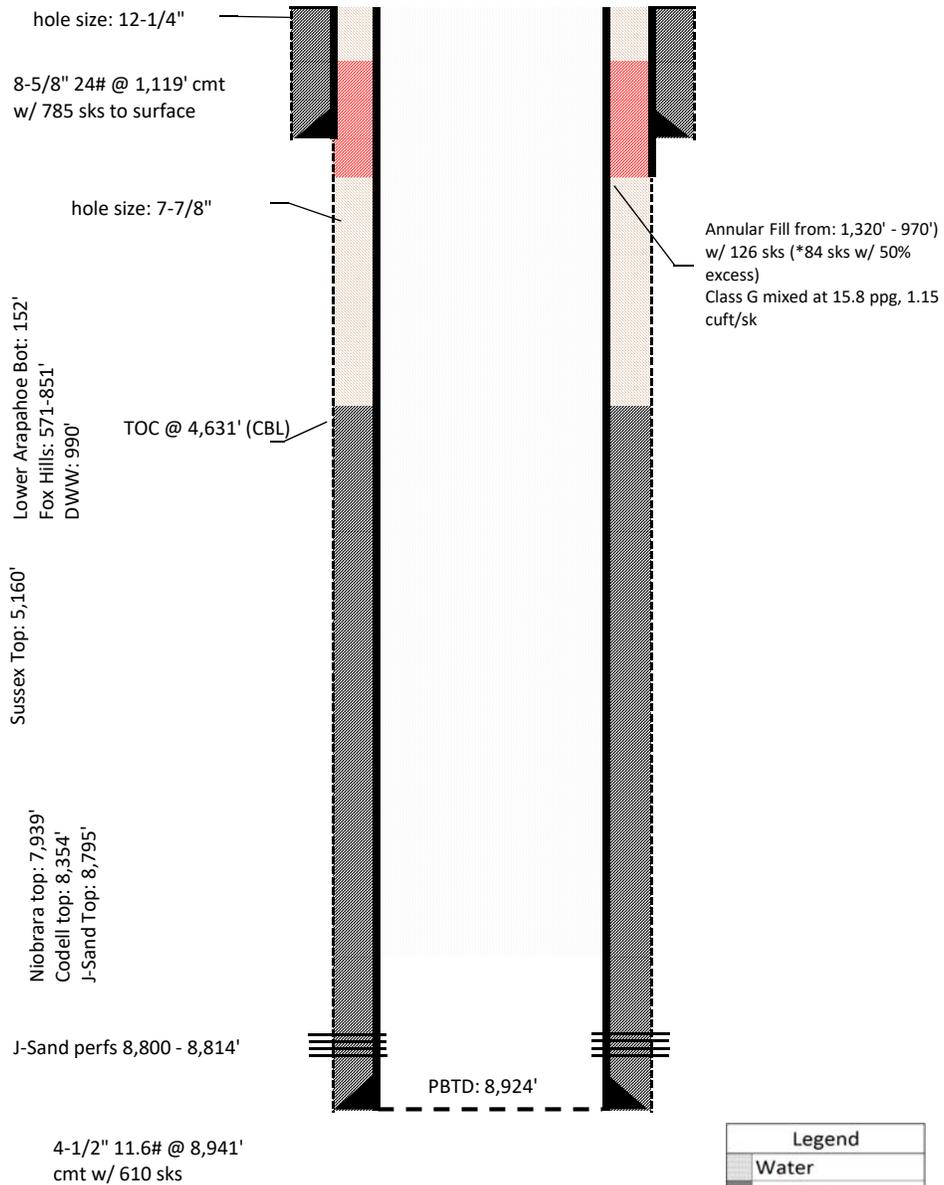

Legend	
	Water
	Existing Cement
	New Cement
	Existing Mud