


CERTIFICATE OF SURVEY
for
Snyder Drilling Co.
Weld County, Colorado

Permit No. 73-239
RECEIVED

MAY 4 1973

COLORADO OIL & GAS COM. REG. MAP.

T11N R61W 6PM

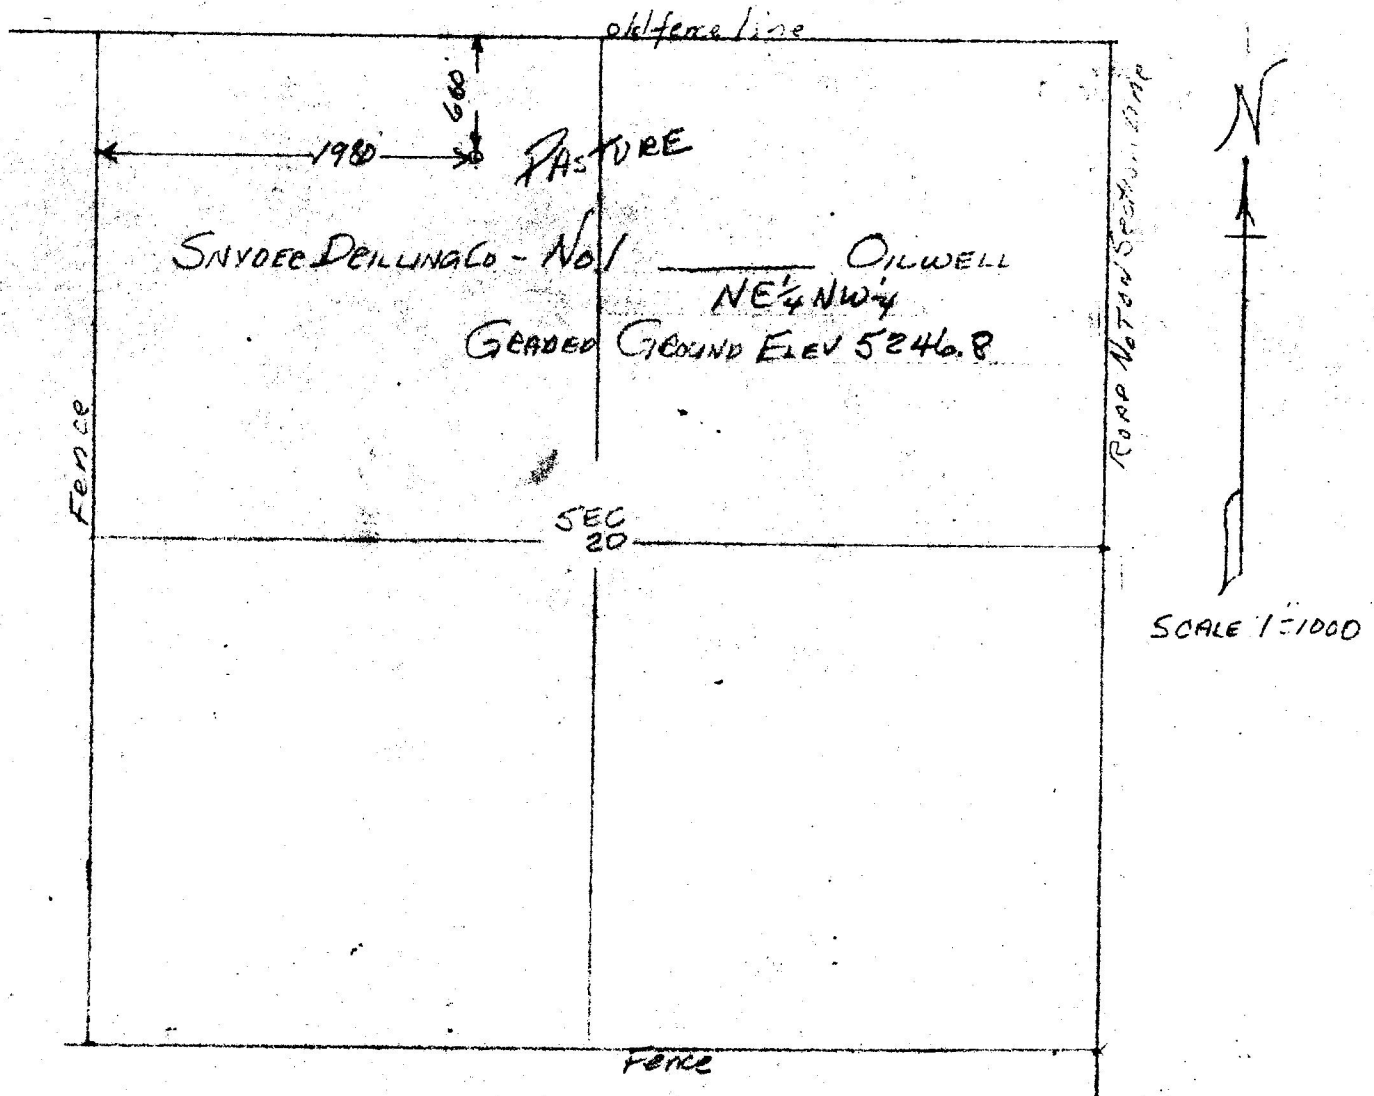

I hereby certify that the above plat is an accurate representation of a correct survey showing the location of Snyder Drilling Co. - No. 1 Oilwell in NE 1/4 NW 1/4 Sec. 20 T11N R61W 6PM. The elevation of the ground at the stake is 5246.8 feet above sea level from U.S.G.S. Bench Mark.

Fort Morgan, Colorado
April 25, 1973

Cecil J. Osborne
Registered Professional Engineer
State of Colorado



00289935

73-239