

CERTIFICATE OF SURVEY
for
Tom Vessels
Weld County, Colorado


RECEIVED

OCT 2 1973

COLO. OIL & GAS CONS. COMM.



T11N (R624) 6PM

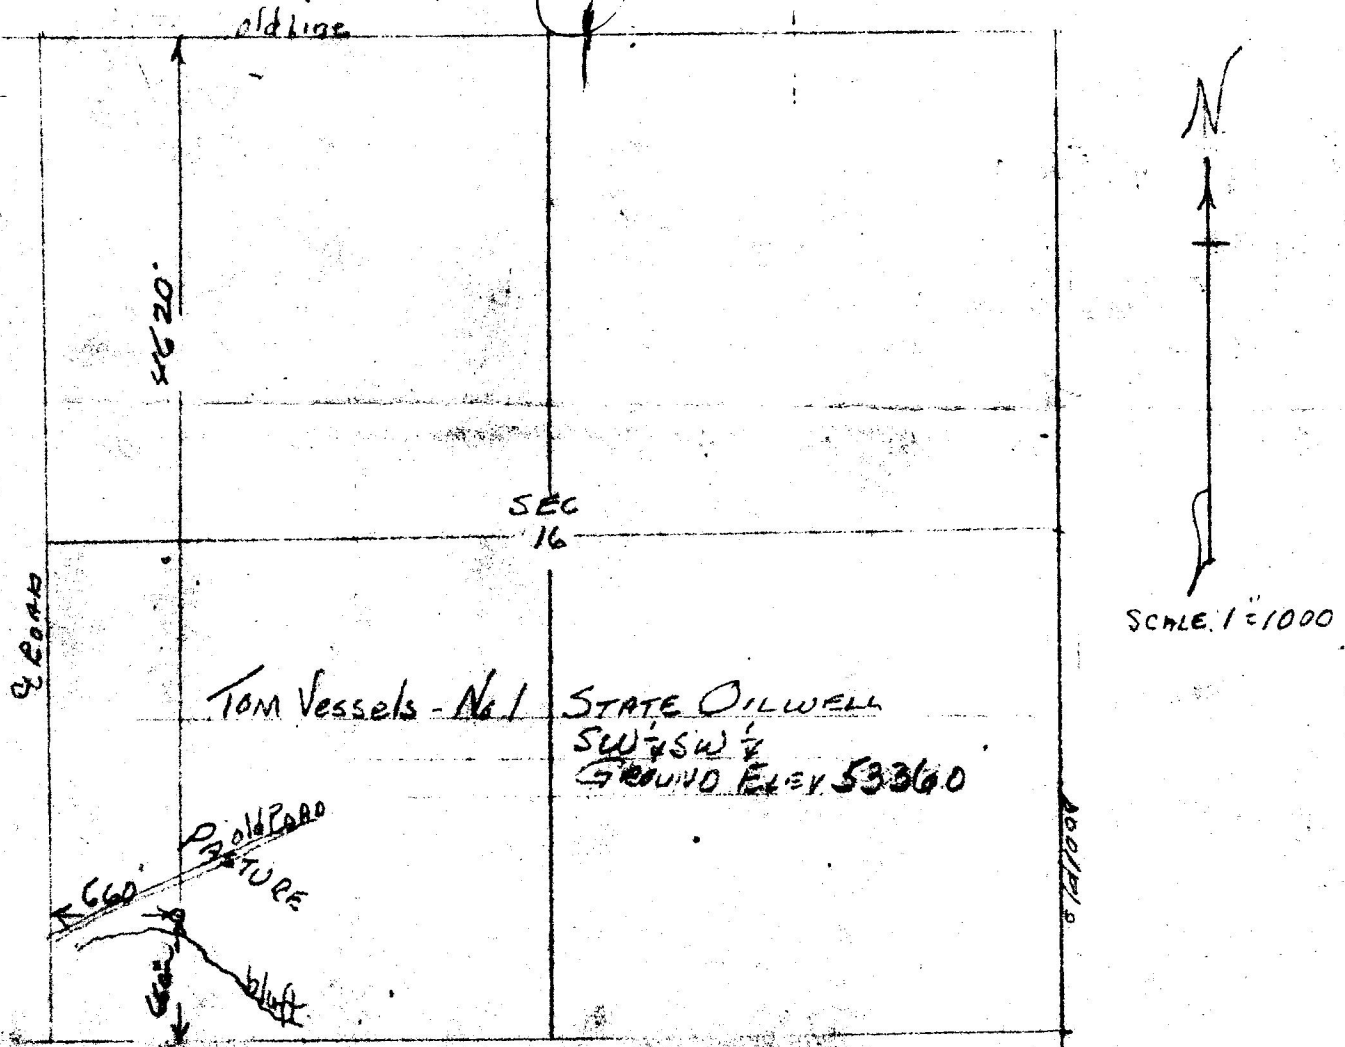

I hereby certify that the above plat is an accurate representation of a correct survey showing the location of Tom Vessels- No.1 State Oilwell in SW $\frac{1}{4}$ SW $\frac{1}{4}$ Sec. 26 T11N R61W 6PM. The elevation of the ground at the stake is 5336.0 feet above sea level from U.S.C.&G. Bench Mark.

Fort Morgan, Colorado
Sept. 23, 1973

Registered Professional Engineer
State of Colorado