Wellbore Diagrams

KUGEL W 4-8
05-123-15194
SENE 4-2N-66W; 2114 FNL & 794 FEL
GERRITY OIL & GAS CORP
DA (10/25/1991)

Current Wellbore Schematic

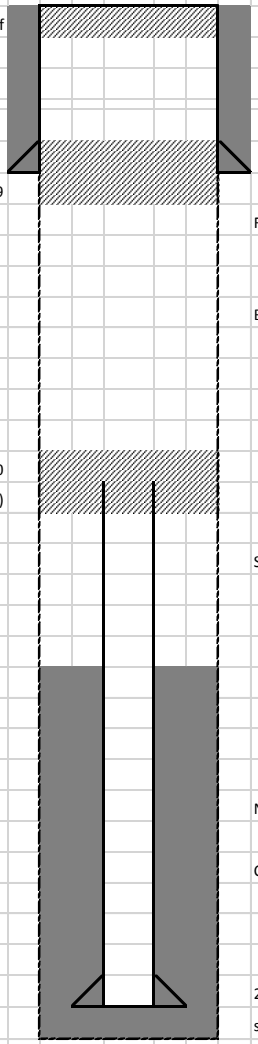

spud	9/23/1991	
10 sks cmt @ surf	KB	4962
	GL	4952
	8 5/8" 24# @	629
	sks cmt	300
40 sks cmt f/ 579-679	12 1/4" OH	
	Fox Hills	655
	Base of Upper Pierre	1746
40 sks cmt f/ 3750-3770		
Cut csg @ 3770 (10/91)		
	Sussex	4412
	TOC (11/91)	6594
	Niobrara	7150
	Codell	7422
	2 7/8" 6.5#	7575
	sks cmt	475
PBTD 7540 ft	7 7/8" OH	
TD 7578 ft		

Drawn: NGK, 4/17/18

KUGEL W 4-8
05-123-15194
SENE 4-2N-66W; 2114 FNL & 794 FEL
GERRITY OIL & GAS CORP
DA (10/25/1991)

Proposed Wellbore Schematic

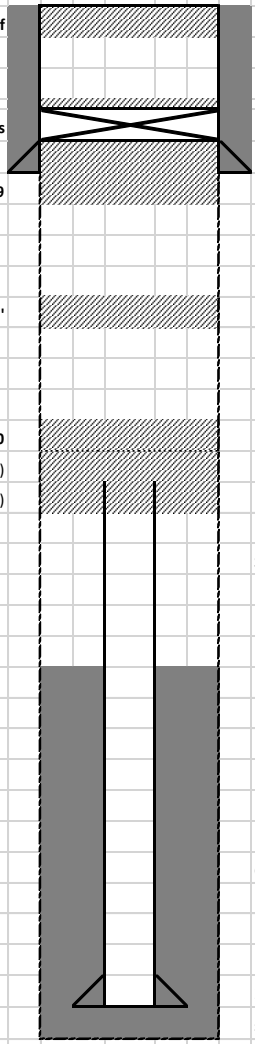

spud	9/23/1991	
20 sks cmt @ surf	KB	4962
	GL	4952
CIBP @ 519' w/ 2sks	8 5/8" 24# @	629
	sks cmt	300
85 sks cmt f/ 529-679	12 1/4" OH	
	Fox Hills	655
170 sks cmt f/1850' to 1650'	Base of Upper Pierre	1746
85 sks G cmt f/ 3750'-3650		
40 sks cmt f/ 3750-3770 (10/91)		
Cut csg @ 3770 (10/91)		
	Sussex	4412
	TOC (11/91)	6594
	Niobrara	7150
	Codell	7422
	2 7/8" 6.5#	7575
	sks cmt	475
PBTD 7540 ft	7 7/8" OH	
TD 7578 ft		

Drawn: NGK, 4/17/18

AFE