


Attachment #1 – Current Wellbore Diagram

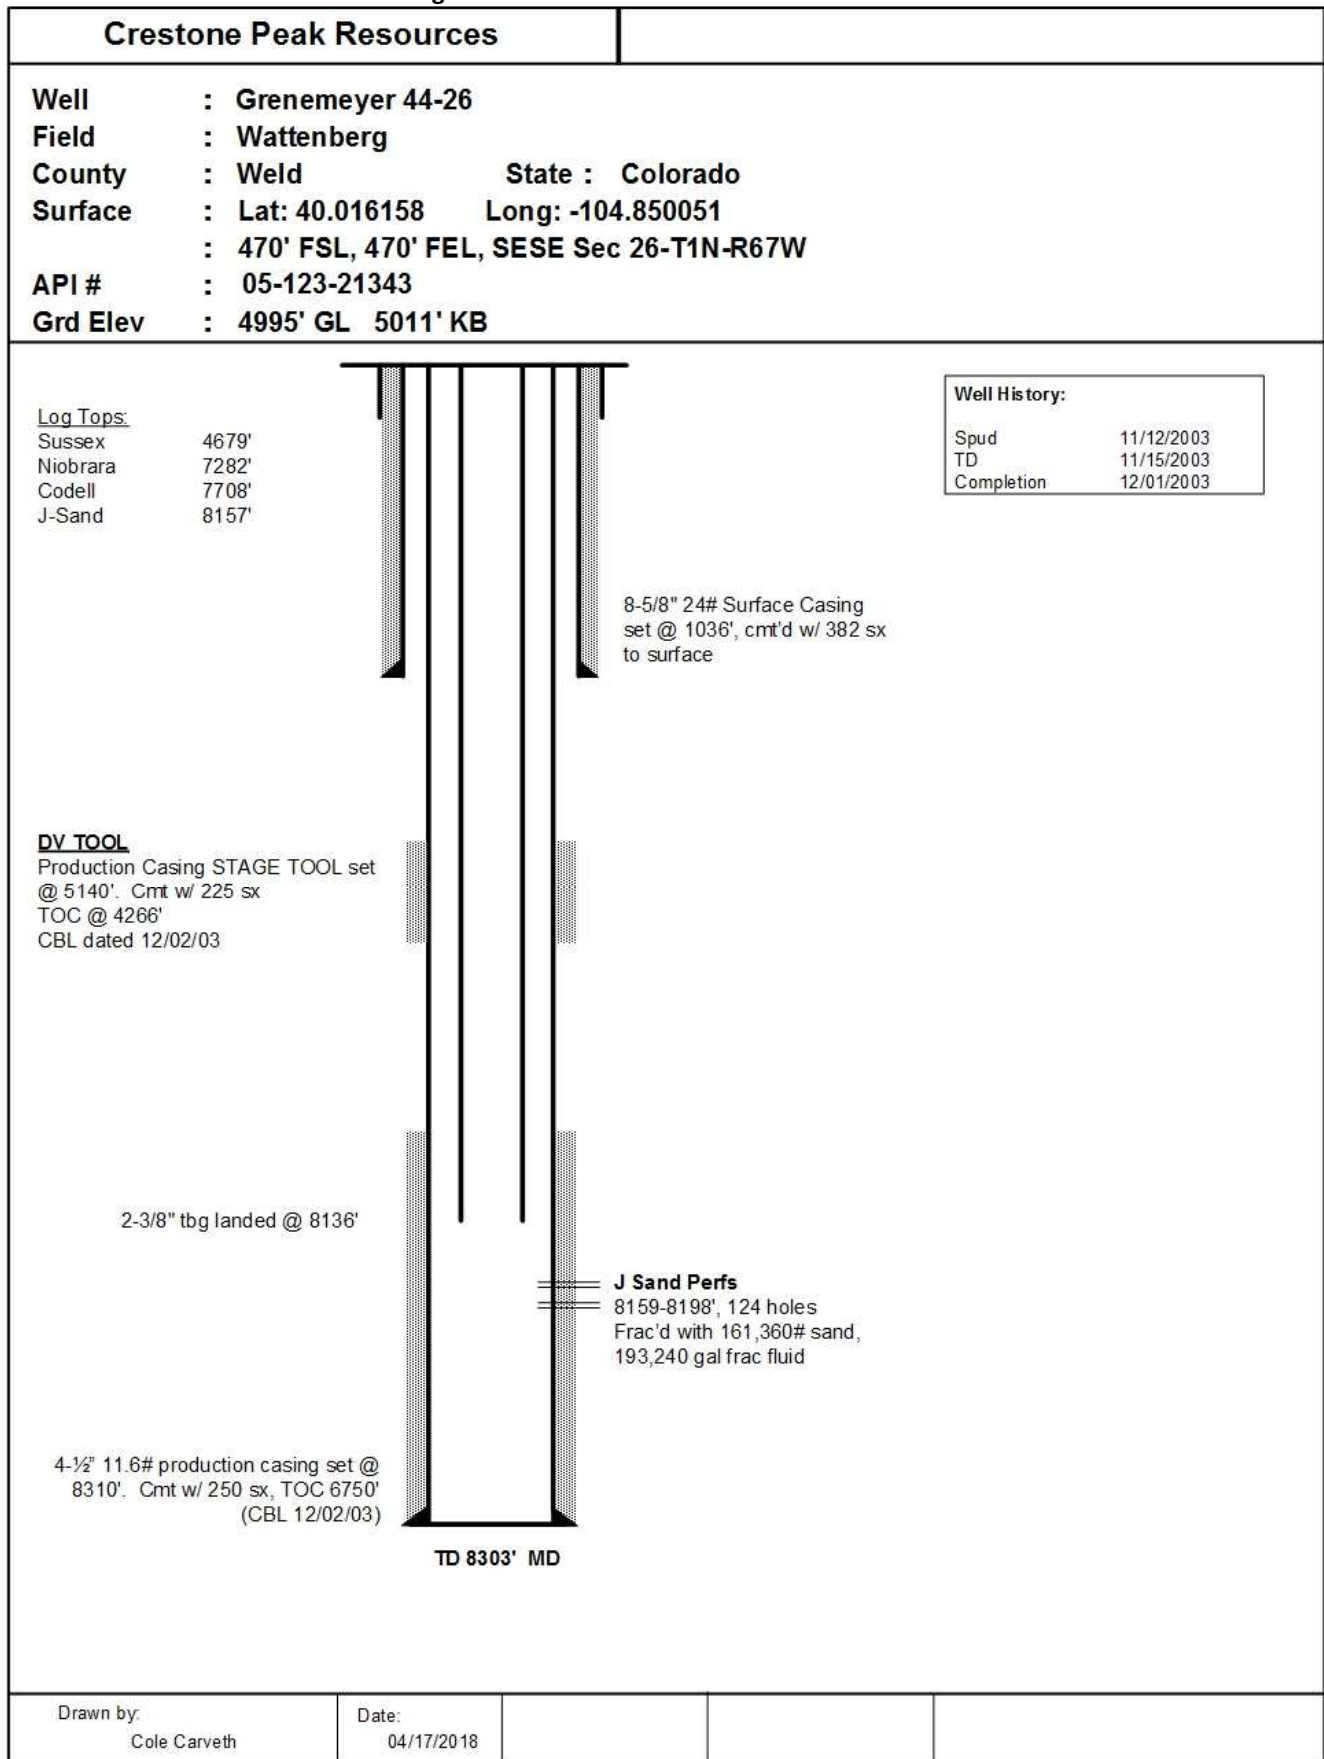

Drawn by:  
Cole Carveth

Date:  
04/17/2018

Attachment #2 – Proposed Plugged Wellbore Diagram

