


Laramie Energy, LLC
 Bruton 30-16W
 Slot A-6
 H&P 522 (30-ft KB)

API # : 05-077-10472
 NW/4 SE/4 S30/T9S/R93W/6th PM
 Mesa County, CO
 Date of diagram : 12/27/2017

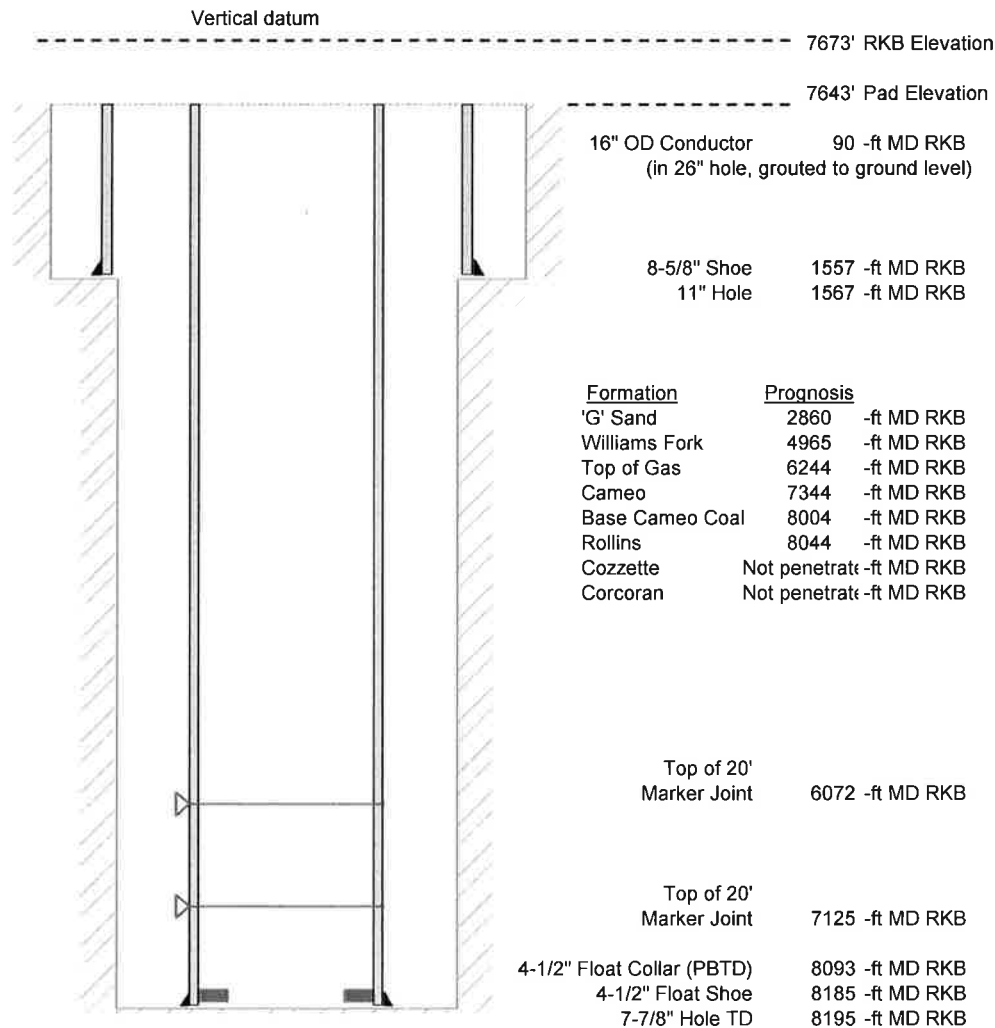

Cementing details

8-5/8" 24# Surface Csg	Lead	Tail
Density (ppg)	12.3	12.8
Volume (sx)	197	109
Yield (cf/sx)	2.45	2.18
Top (ft RKB)	0	1030
Bottom (ft RKB)	1030	1557
Returns (full or partial)	Full	Full

4-1/2" 11.6# Prod Csg	Lead	Tail
Density (ppg)	12.5	13.3
Volume (sx)	881	461
Yield (cf/sx)	1.94	1.73
Est Top (ft RKB)	0	
Est Bottom (ft RKB)	6044	8185
Returns (full or partial)	Full	Full

Displacement
8.3 ppg
125.4 bbls

Other Remarks : 33 bbls to surface on surface job, 35 bbls spacer to surface on production job.