
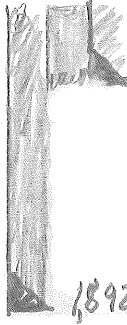


Anadarko

Quarter Circle Z4-24Z API 05-123-46266

KB=20'

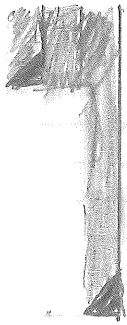

100' @ KB 16" Conductor

1,892' @ KB 9-5/8" Surface Casing

8.5" Open Hole

Open Hole
2 Original Wellbore
12,844' MD @ KB
7,527' TV @ KB

Open Hole
Side track
9,457' MD @ KB
7,604' TV @ KB
Inclination

Not To Scale

Zach Haynes
Anadarko Petroleum
Drilling Engineer
614-832-6675

500 SHEETS FULLER 5 SQUARE
50 SHEETS EVEREAD 5 SQUARE
100 SHEETS EVEREAD 5 SQUARE
200 SHEETS EVEREAD 5 SQUARE
400 SHEETS EVEREAD 5 SQUARE
200 RECYCLED WHITE 5 SQUARE

19-782
42-381
42-382
43-000



Made in U.S.A.