



00017376

CERTIFICATE OF SURVEY
for
Bronco Oil and Gas Co.
Weld County, Colorado


RECEIVED

SEP 3 1976

COLO. OIL & GAS CONS. COMM.

T1N R63W 6PM

Hy 52

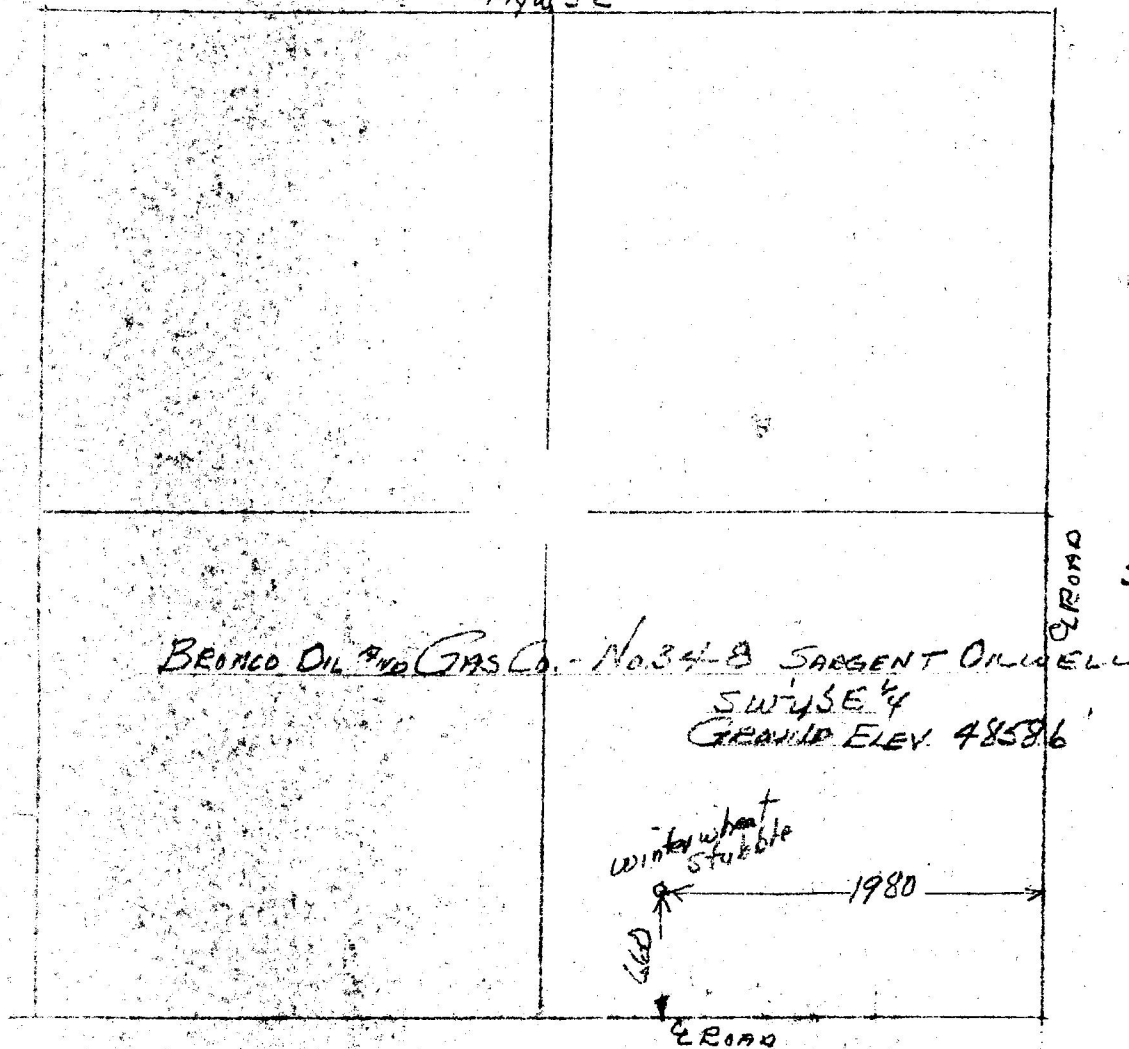

I hereby certify that the above plat is an accurate representation of a correct survey showing the location of Bronco Oil and Gas Co. - No. 34-8 Oilwell in SW 1/4 SE 1/4 Sec. 8 T1N R63W 6PM. The elevation of the ground at the stake is 4858.6 feet above sea level from U.S.G.S. Bench Mark.

Fort Morgan, Colorado
Aug. 29, 1976

Kevin J. Osborne

Registered Professional Engineer
State of Colorado