


Thomas L Spring, LLC

Wollert B #3


Current

Surface Casing
Diameter: 8 5/8"
Weight: 24#
Depth: 305'

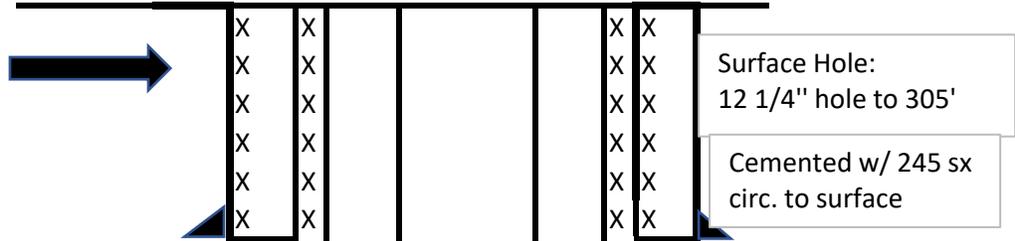

480 sx cement
DV tool @ 3004'

Production Casing
Diameter: 4 1/2"
Weight: 10.5#
Depth: 4691'

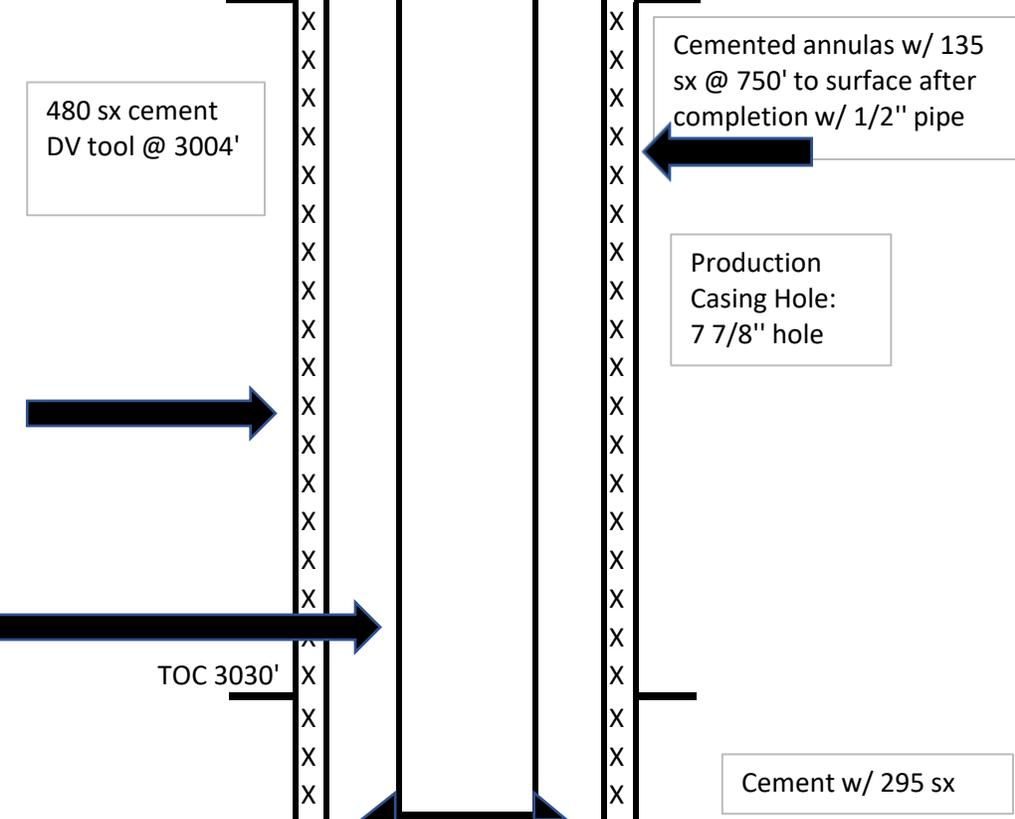

Production Tubing
Diameter: 2 3/8"
Weight: 4.7#
Depth: 4670'

