

CERTIFICATE OF SURVEY
for
Patrick A. Doherty
Morgan County, Colorado


606 Cons Can

RECEIVED

MAR - 2 1967

COLO. OIL & GAS CONS. COMM.

T2N R58W6PM.

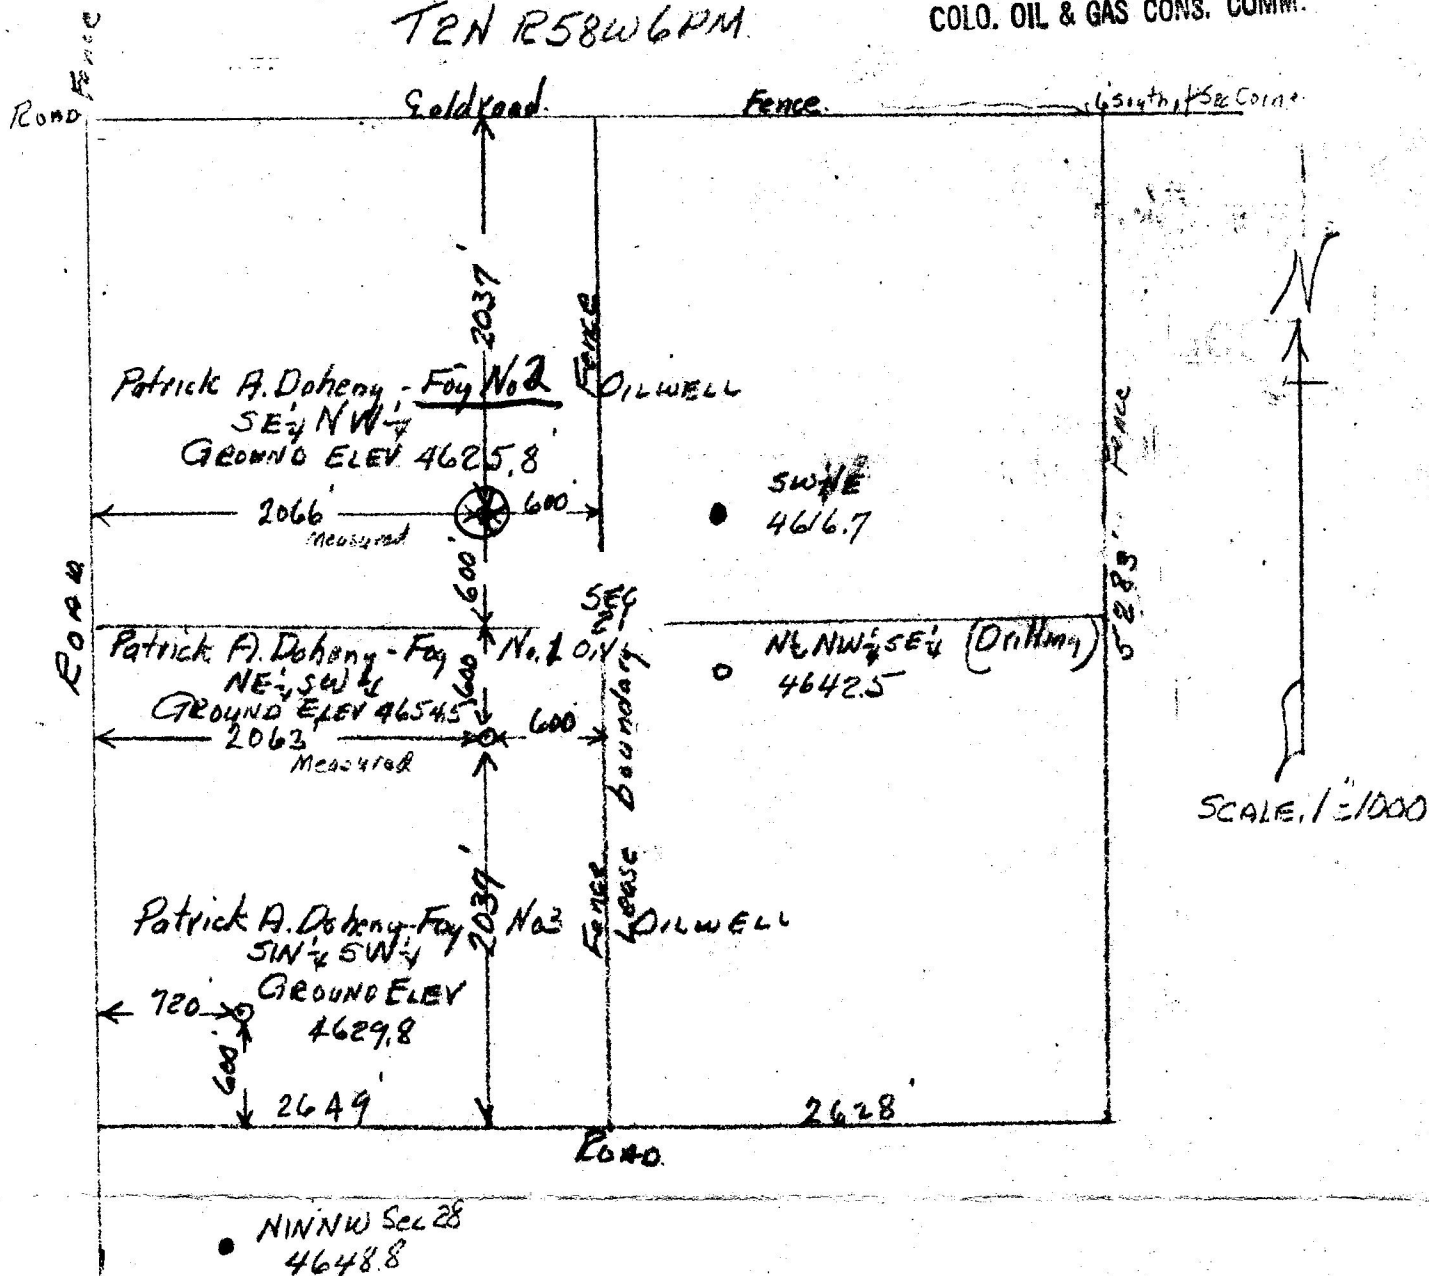

I hereby certify that the above plat is an accurate representation of a correct survey showing the location of Patrick A. Doherty-Fwy No. 1 Oil well in NE 1/4 SW 1/4 Sec. 21 T2N R58W 6PM, Ground elevation 4654.5 feet above sea level; Patrick A. Doherty-Fwy No. 2 Oil well in SE 1/4 NW 1/4 Sec. 21 T2N R58W 6PM, Ground elevation 4625.8 feet above sea level; Patrick A. Doherty-Fwy No. 3 Oil well in SW 1/4 SW 1/4 Sec. 21 T2N R58W 6PM. The elevation of the ground at the stake 4629.8 feet above sea level from U.S.C.G. bench mark.

Pat. A. Doherty, O.G. owner
Pat. No. 1, 2, 3

Robert J. Roberson
Registered Professional Engineer
State of Colorado



00076319

67-32

21-2 N-58 Fwy 2