


CERTIFICATE OF SURVEY
for
Patrick A. Doherty
Morgan County, Colorado

RECEIVED

MAR - 9 1967

COLO. OIL & GAS CONS. COMM.

T2N R58W 6PM

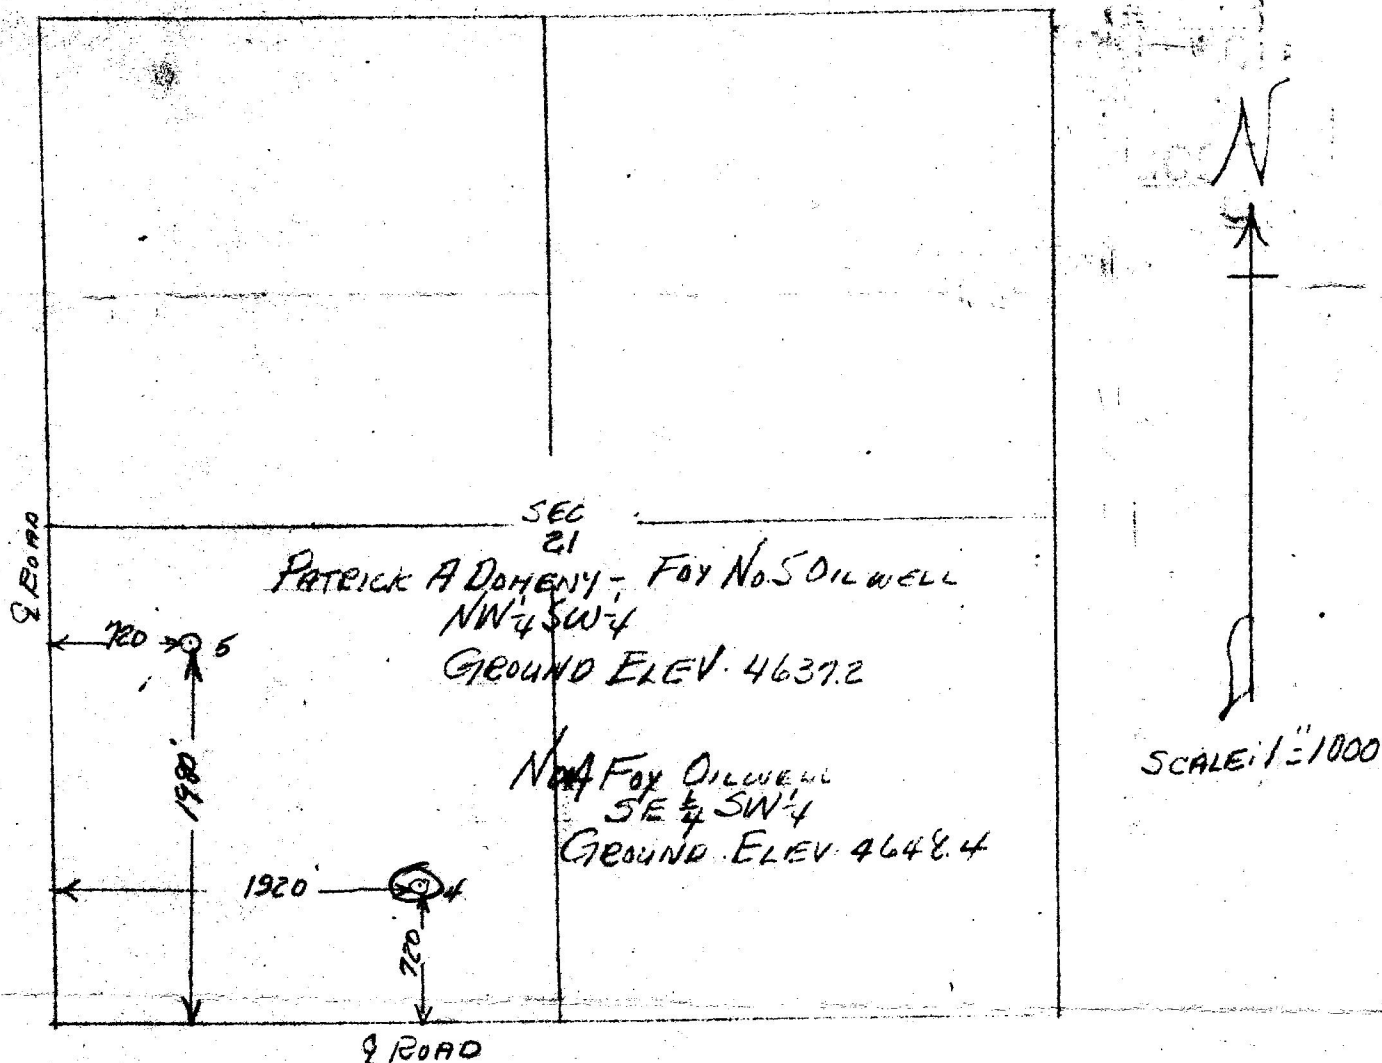

I hereby certify that the above plat is an accurate representation of a correct survey showing the location of Patrick A. Doheny Foy No. 4 Oilwell in SE1/4 Sec. 21 T2N R56W 6PM, ground elevation 464.4 feet above sea level. And Patrick A. Doheny-Foy No. 5 Oilwell in NW1/4 Sec. 21 T2N R56W 6PM. The elevation of the ground at the stake is 4639.2 feet above sea level from U.S.C.&G. Bench Mark.

Fort Morgan, Colorado
March 5, 1967

Registered Professional Engineer
State of Colorado



00076341

67, 67,