


CERTIFICATE OF SURVEY
for
Patrick A. Doherty
Morgan County, Colorado

6010 Cons Com
RECEIVED

MAR - 2 1967

COLO. OIL & GAS CONS. COMM.

T2N R58W6PM

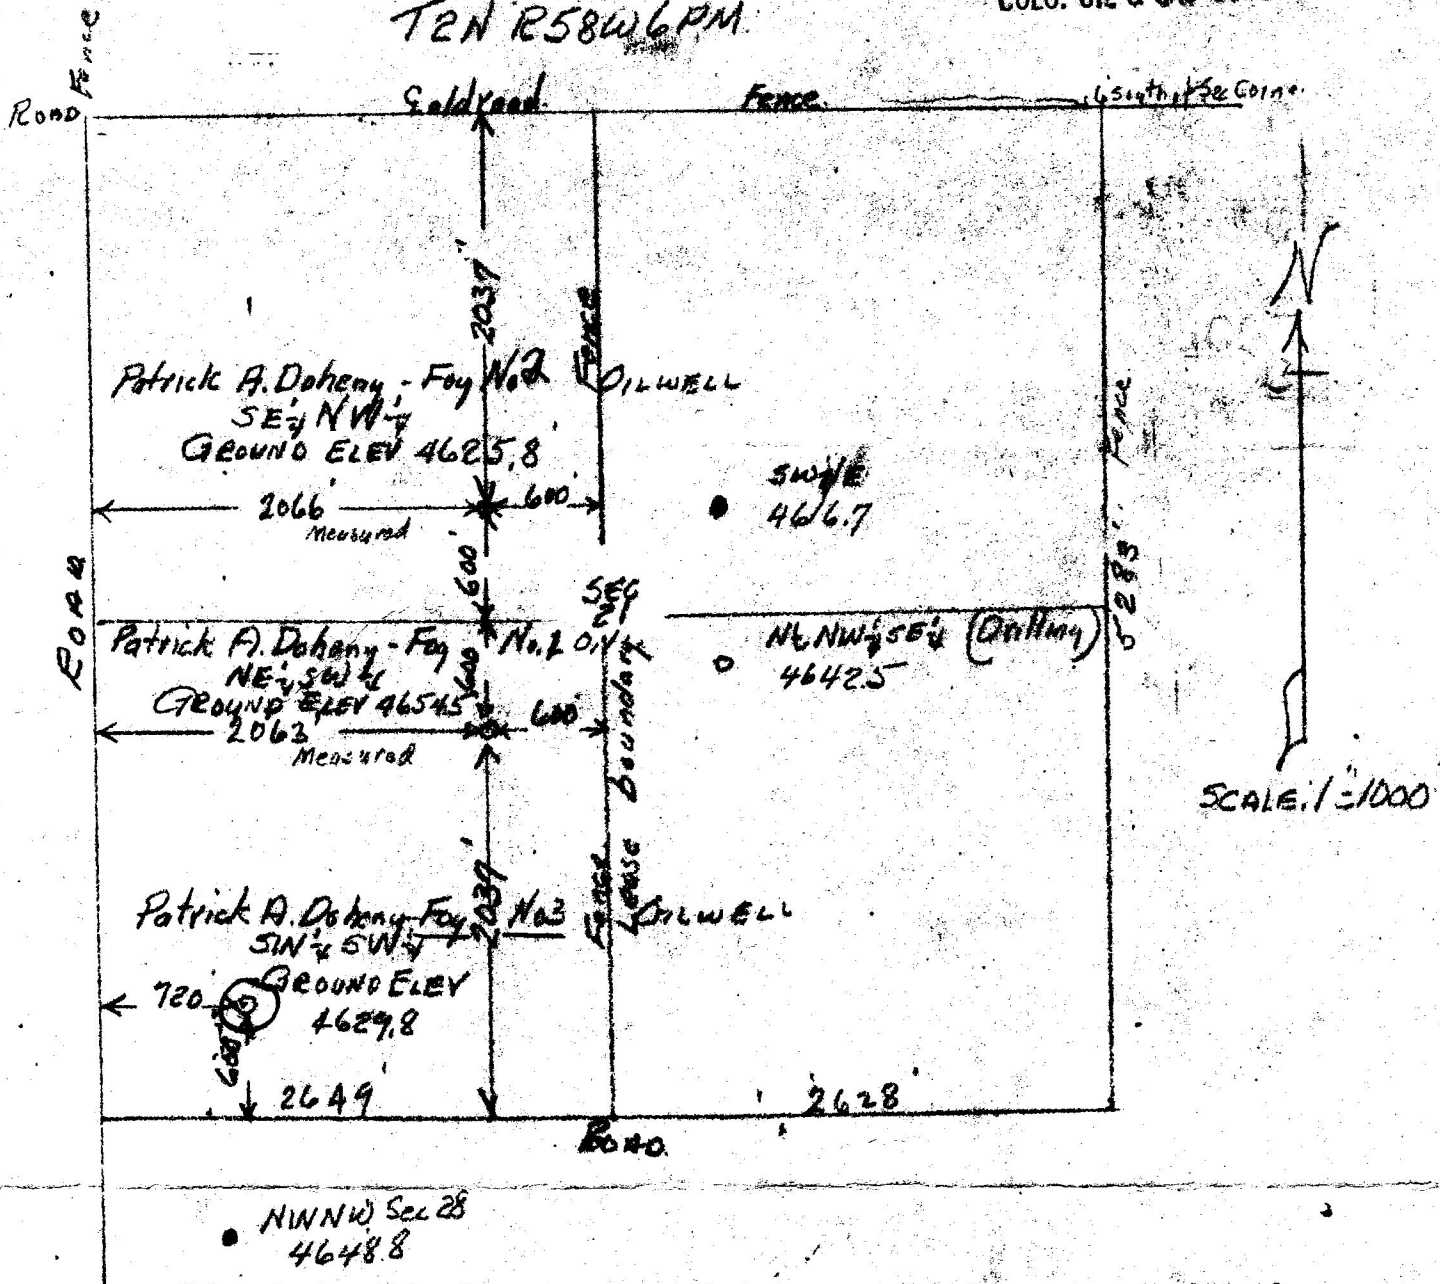

I hereby certify that the above plat is an accurate representation of a recent survey showing the location of Patrick A. Doherty-Foy No. 1 Oilwell in NE 1/4 SW 1/4 Sec. 21 T2N R58W 6PM, Ground elevation 4654.5 feet above sea level; Patrick A. Doherty-Foy No. 2 Oilwell in SE 1/4 NW 1/4 Sec. 21 T2N R58W 6PM, Ground elevation 4625.8 feet above sea level; Patrick A. Doherty-Foy No. 3 Oilwell in SW 1/4 SW 1/4 Sec. 21 T2N R58W 6PM. The elevation of the ground at the stake 4629.8 feet above sea level from U.S.C.S.C. Bench Mark.

Fort Morgan, Colorado
Feb. 26, 1967

Loeud J. Osborne
Registered Professional Engineer
State of Colorado



00076331

67-55