




CERTIFICATE OF SURVEY
for
Al Ward
Washington County, Colorado

RECEIVED

AUG 10 1971

COLO. OIL & GAS CONS. COMM.

T2N R524 6PM

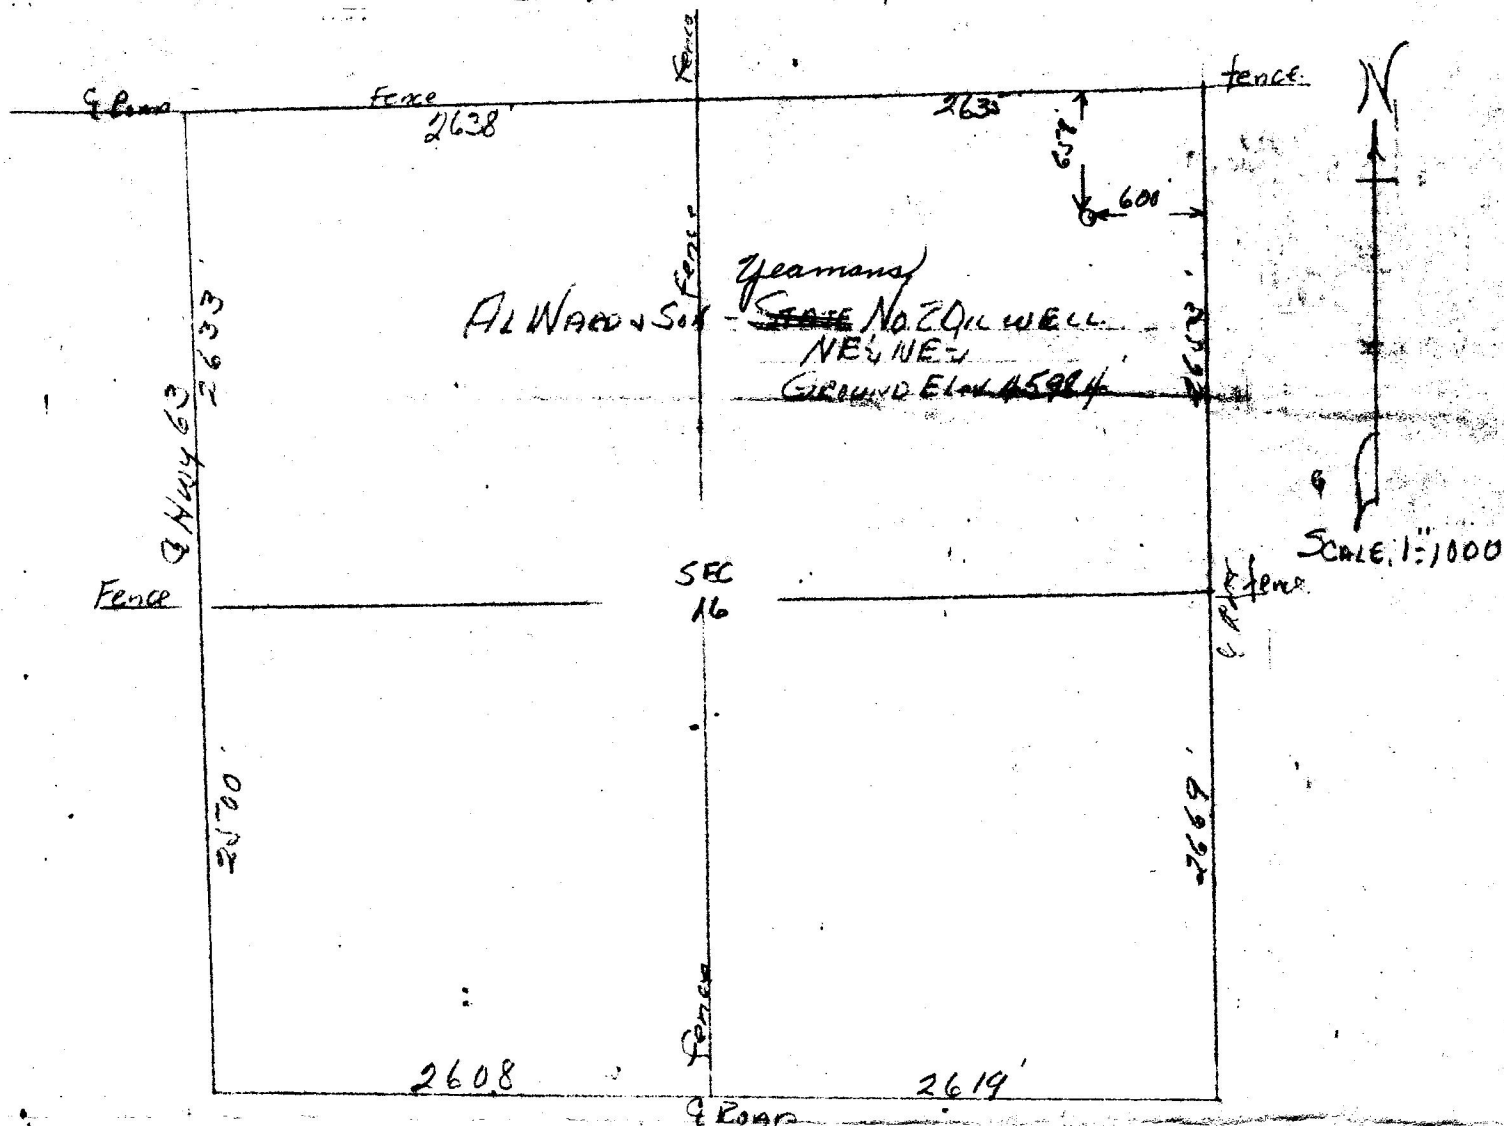

I hereby certify that the above plat is an accurate representation of a correct survey showing the location of Al Ward and Son - ~~State No 2~~ *Various* Oilwell in ~~NE 1/4~~ Sec. 16 T2N R52W 6PM. The elevation of the ground at the stake is 4598.4 feet above sea level from U.S.C. & G. Bench Mark.

Fort Morgan, Colorado
July 26, 1971

Registered Professional Engineer
State of Colorado