

Colo Cons Com

CERTIFICATE OF SURVEY
for
Patrick A. Doheny
Washington County, Colorado



RECEIVED

APR 18 1968

COLO. OIL & GAS CONS. COMM.

00047452

T2N R52W 6PM

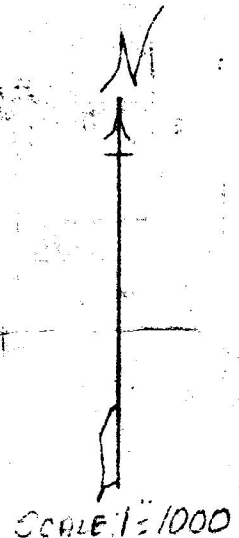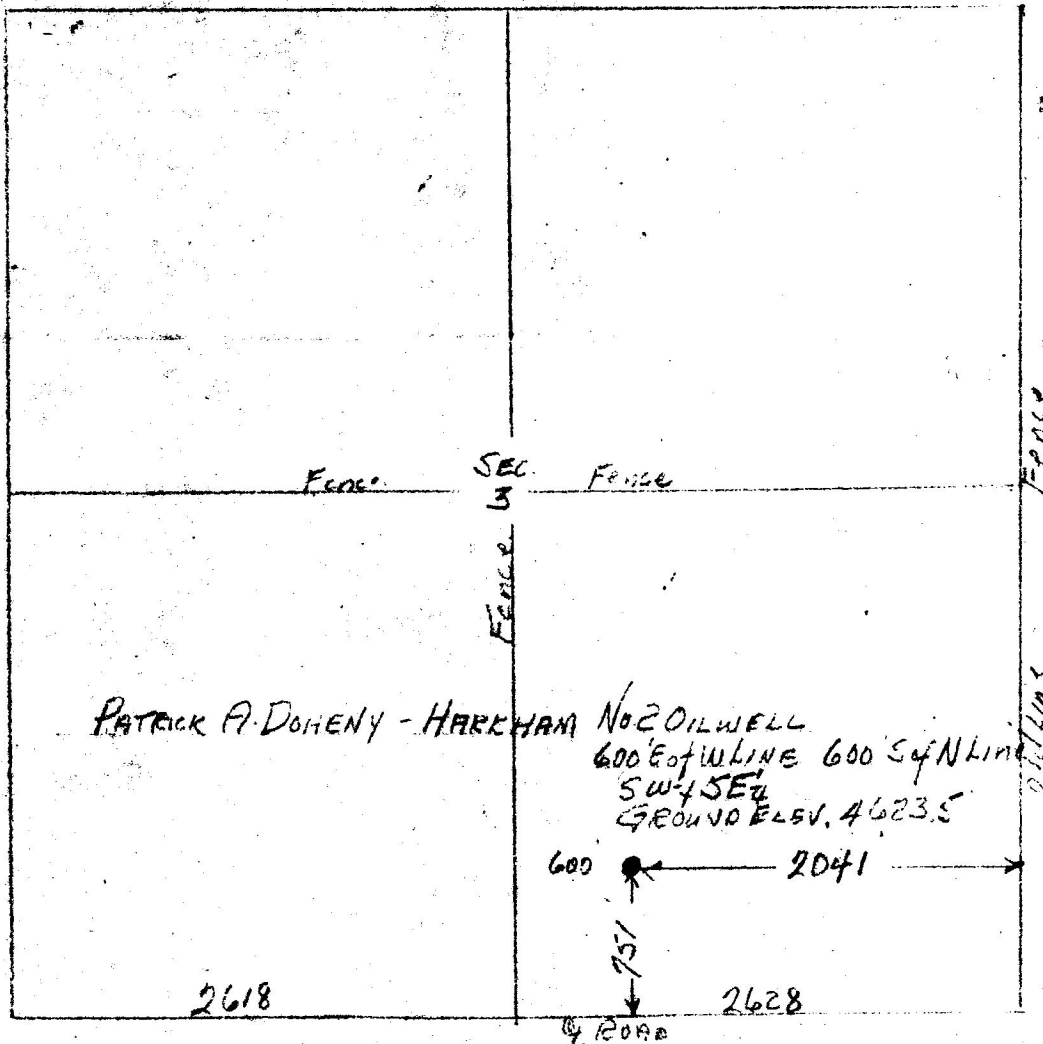

I hereby certify that the above plat is an accurate representation of a correct survey showing the location of Patrick A. Doheny-Harkham No. 2 Oilwell 600 feet south of north line 600 feet east of west line SW 1/4 SE 1/4 Sec. 3 T 2N R 52W 6PM. The elevation of the ground at the stake is 4623.5 feet above sea level from U.S.C.&G. Bench Mark.

Fort Morgan, Colorado
April 11, 1968

Paul Osborne
Registered Professional Engineer
State of Colorado

68-96

BEST COPY
AVAILABLE

5