




CERTIFICATE OF SURVEY
for
U.S. Mining, Smelting and Refining Co.
Morgan County, Colorado

RECEIVED

APR 18 1967

COLO. OIL & GAS CONG. COMM.

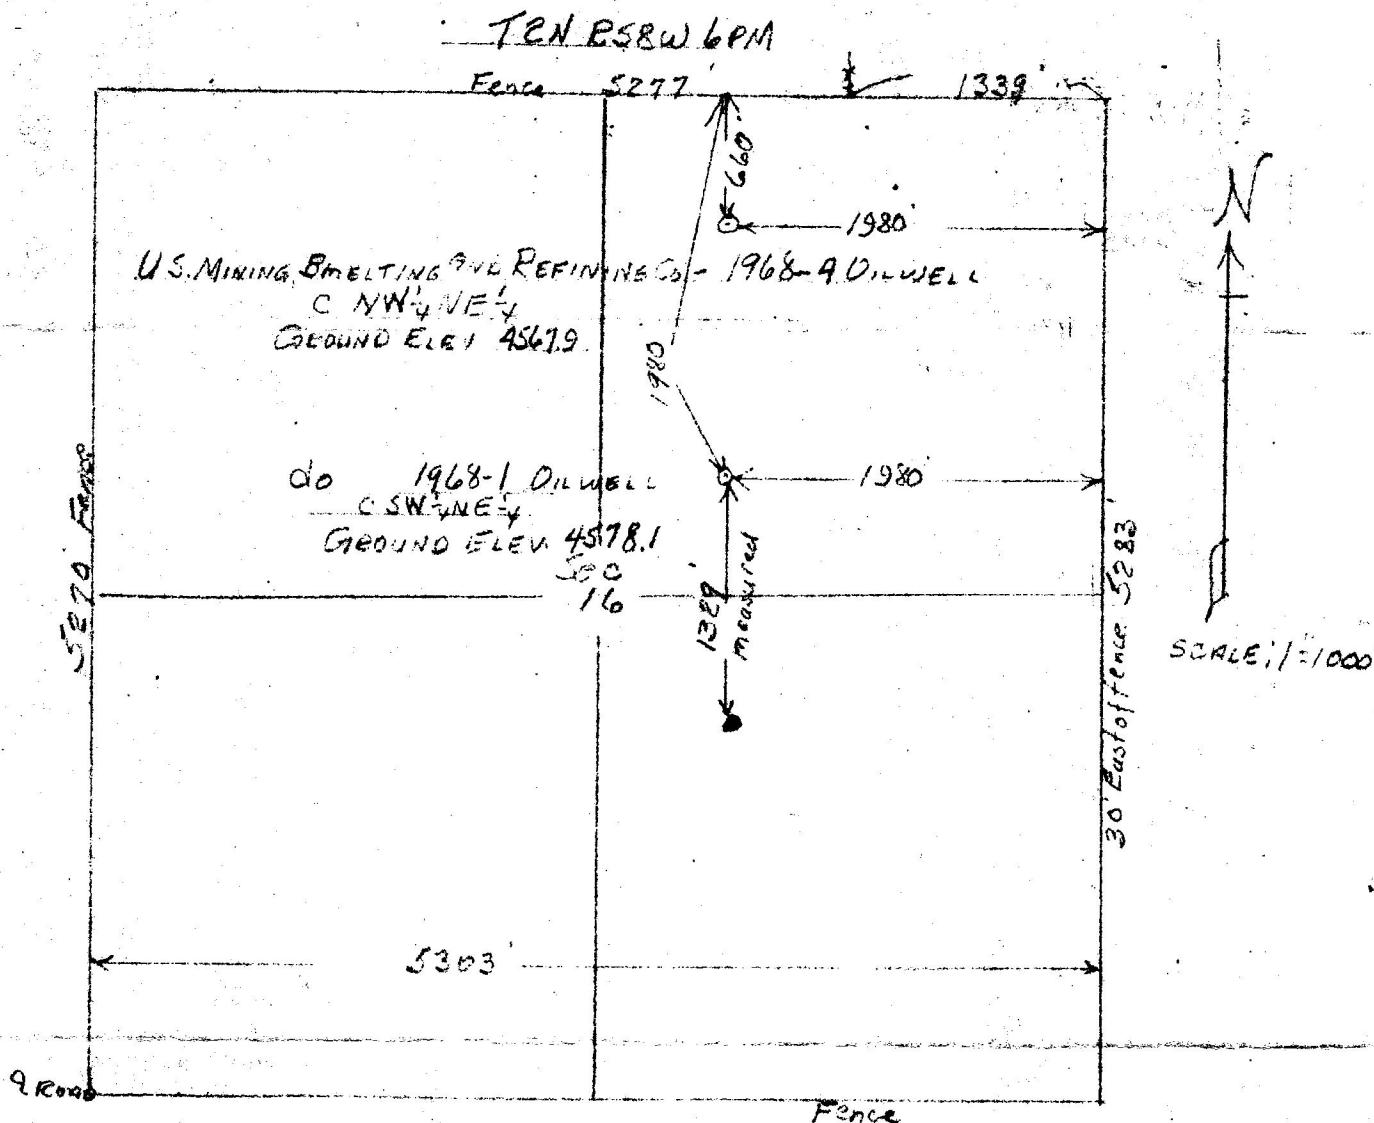

I hereby certify that the above plat is an accurate representation of a correct survey showing the location of U.S. Mining, Smelting and Refining Co. - State 1968-1 Oilwell in C SW 1/4 NE 1/4 Sec. 16 T2N R58W 6PM. Ground elevation 4578.1 feet above sea level, and State 1968-4 Oilwell in C NW 1/4 NE 1/4 Sec. 16 T2N R58W 6PM. The elevation of the ground at the stake is 4567.9 feet above sea level from U.S.C.&G. Bench Mark.

Fort Morgan, Colorado
April 15, 1967

Reed J. Osborn
Registered Professional Engineer
State of Colorado