

APR 12 1967

CERTIFICATE OF SURVEY
for
Art Skaer
Morgan County, Colorado


RECEIVED

AUG - 1 1967

COLO. OIL & GAS CONS. COMM.

TEN R58W 6PM.

5281 Fence

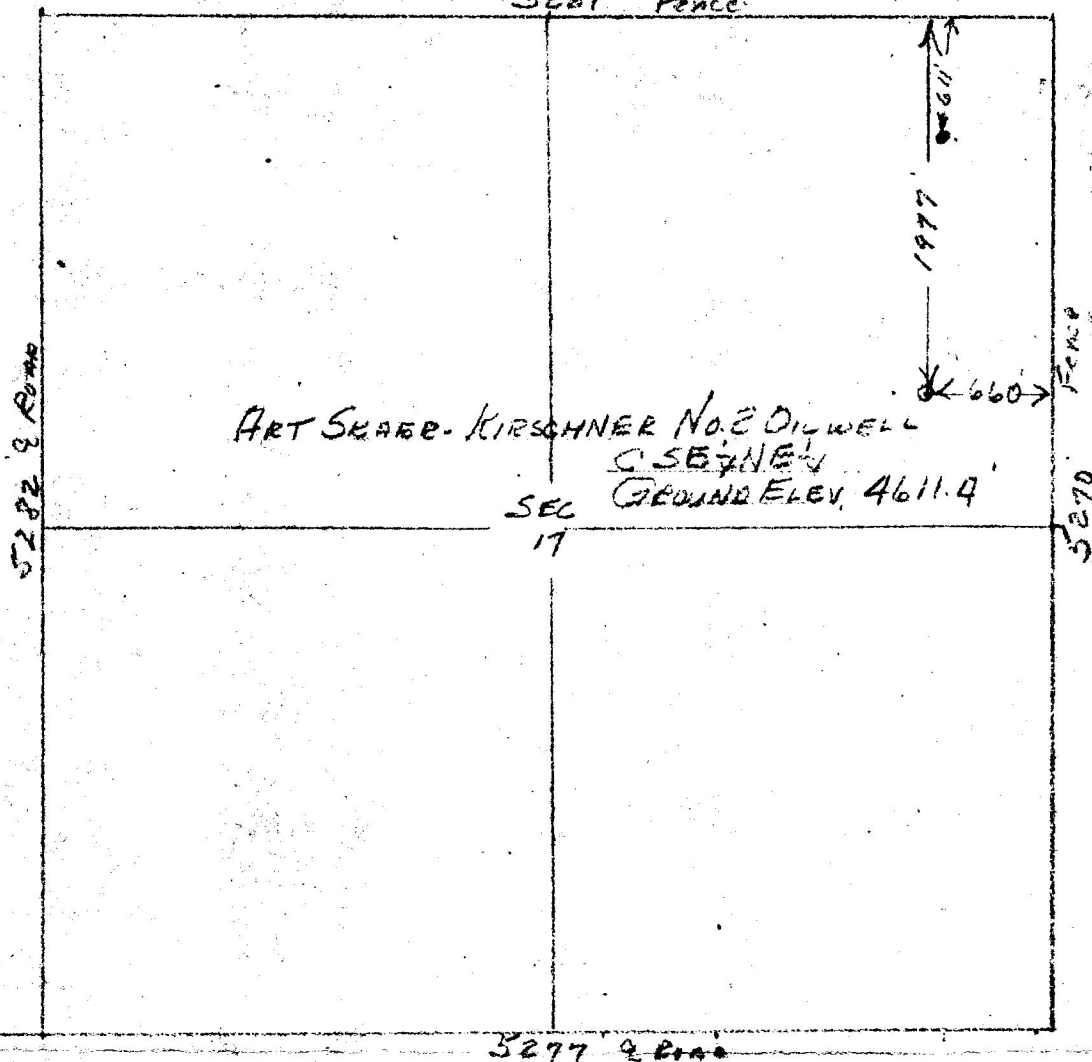

I hereby certify that the above plat is an accurate representation of a correct survey showing the location of Art Skaer-Kirschner No.2 Oilwell in ~~C 527NE~~ Sec. 17 T2N R58W 6PM. The elevation of the ground at the stake is 4611.4 feet above sea level from U.S.C.&G. Bench Mark.

Fert Morgan, Colorado
April 5, 1967

Laecil Osborne
Registered Professional Engineer
State of Colorado



00076128