


Colo Cons Com

CERTIFICATE OF SURVEY
for
Patrick A. Doheny
Morgan County, Colorado



Aug - 8 1967
COLO. OIL & GAS CONS. COMM.

T2N R58W 6PM.

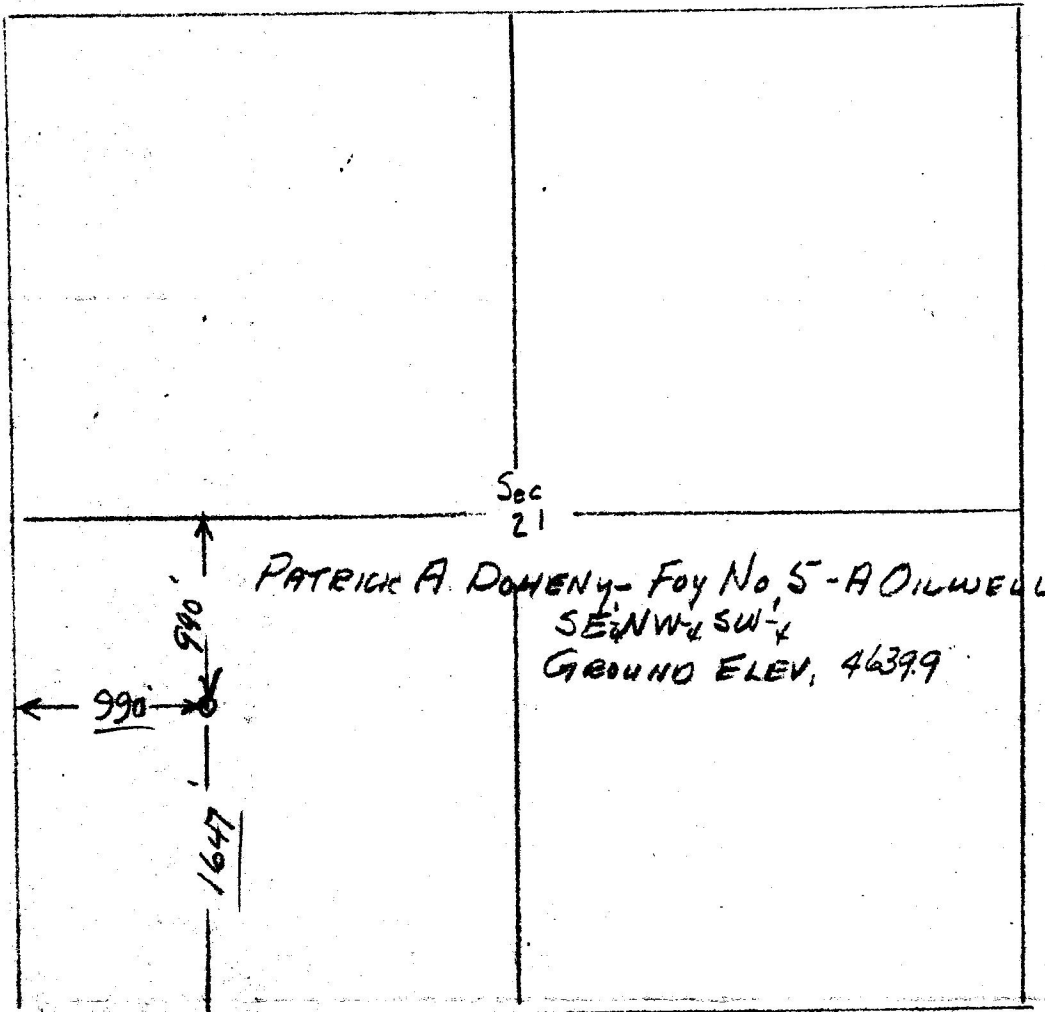

I hereby certify that the above plat is an accurate representation of a correct survey showing the location of Patrick A. Doheny-Foy No. 5A Oilwell in SE 1/4 NW 1/4 SW 1/4 Sec. 21 T2N R58W 6PM. The elevation of the ground at the stake is 4639.9 feet above sea level from U.S.C.&G. Bench Mark.

Fort Morgan, Colorado
July 31, 1967

Cecil J. Osborne
Registered Professional Engineer
State of Colorado

67-312