

Colo Cons Comm


CERTIFICATE OF SURVEY  
for  
Patrick A. Doherty  
Morgan County, Colorado

RECEIVED

MAR - 9 1967

COLO. OIL & GAS CONS. COMM.

T2N R58W 6PM

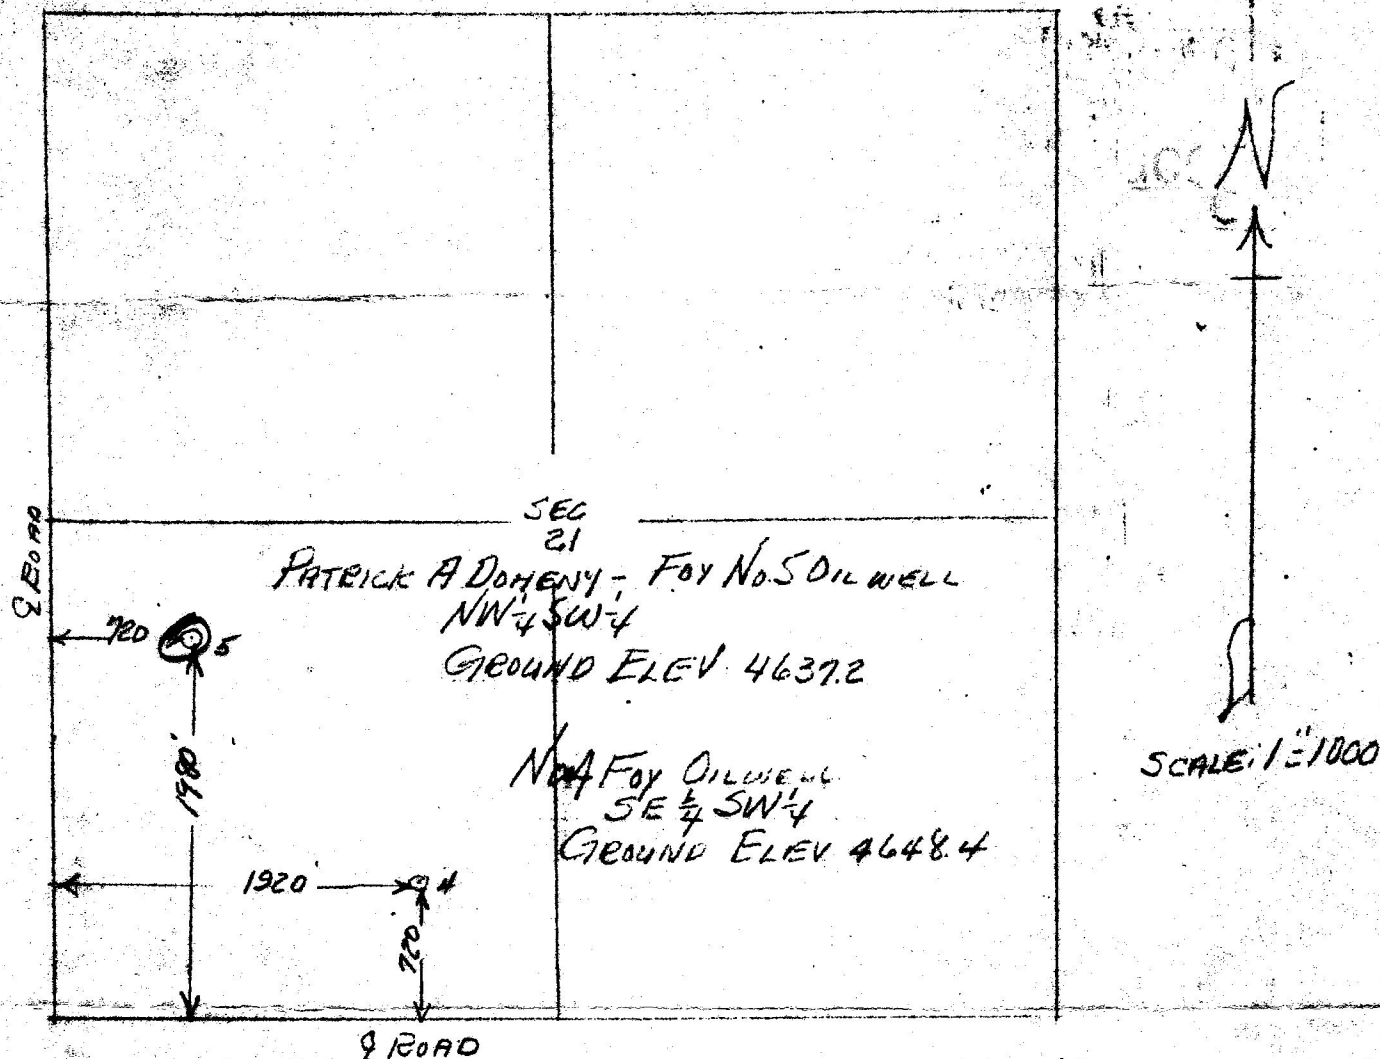

I hereby certify that the above plat is an accurate representation of a correct survey showing the location of Patrick A. Doherty Foy No. 4 Oilwell in SE 1/4 Sec. 21 T2N R58W 6PM, ground elevation 4642.4 feet above sea level. And Patrick A. Doherty-Foy No. 5 Oilwell in NW 1/4 Sec. 21 T2N R58W 6PM. The elevation of the ground at the stake is 4637.2 feet above sea level from U.S.C. & G. Bench Mark.

Fort Morgan, Colorado  
March 5, 1967

*David J. Doherty*  
Registered Professional Engineer  
State of Colorado



00076348

67-68