



Holloway & Holloway, Inc.


P.O. Box 3331
Greeley, CO 80633
(303) 867-3715
(303) 352-5852

N88°58'W 5272'


R67W

NE cor. re-bar
in roadway

N

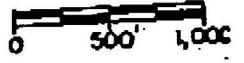

cor. re-bar

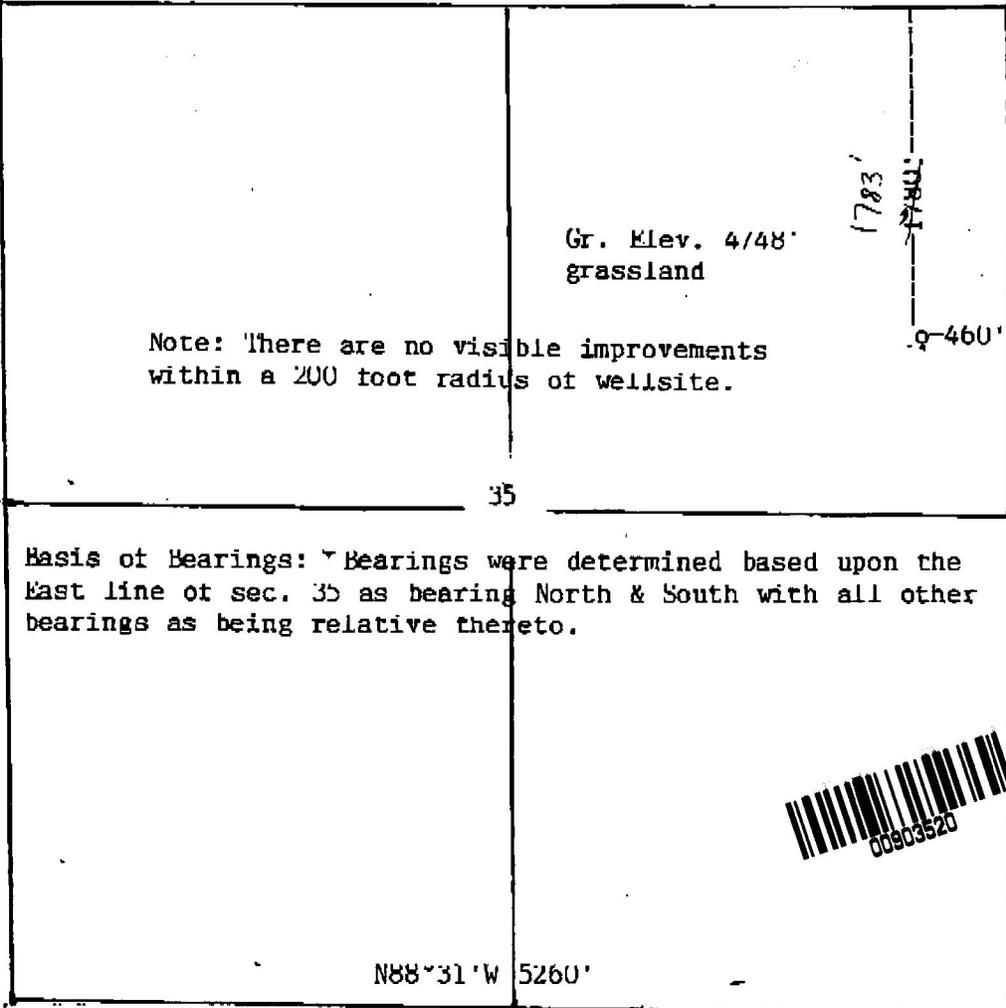

Note: There are no visible improvements within a 200 foot radius of well site.

Basis of Bearings: Bearings were determined based upon the East line of sec. 35 as bearing North & South with all other bearings as being relative thereto.



NOTE

SE cor. re-bar

cor. capped
ument

Scale --- 1" = 1000'

Basis of elev spot elev
at SE cor. 4776'

In accordance with a request from H.S. Resources, Inc.
the Undersigned has determined the location of the

HSR-Sharky 8-35

well

to be ~~1780'~~ FNL & 460' FEL at right angles
~~1783'~~ FNL

as co-ordinates

Section 35 Township 4N Range 67W of the 6th principal Meridian

Weld County, Colorado.

I hereby certify, H.S. Resources, Inc.
that this oil and/or gas well location certificate was prepared for
that it is not a land survey plat or improvement survey plat, and that it is not to be relied upon for the
establishment of fence, building or other future improvement lines

Date 14-5-2001

Ray D. Holloway

Holloway & Holloway, Inc.
States of

Colorado

