


CERTIFICATE OF SURVEY
for
Patrick A. Doheny
Morgan County, Colorado

RECEIVED

MAR 16 1967

COLO. OIL & GAS CONS. COMM.

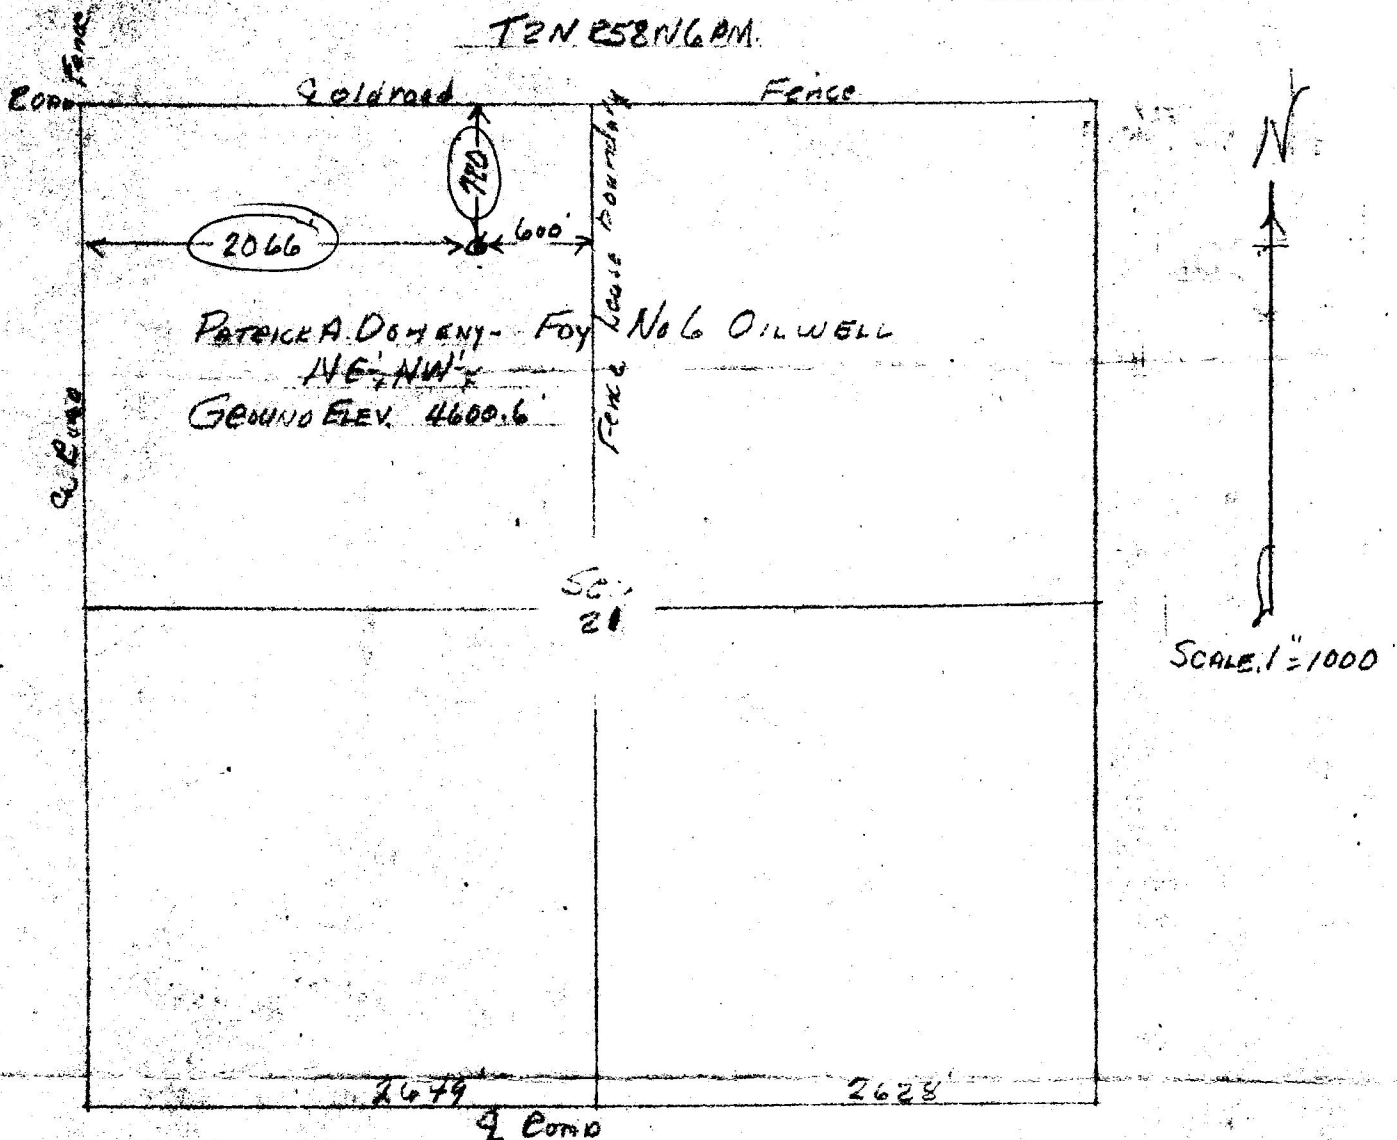

I hereby certify that the above plat is an accurate representation of a correct survey showing the location of Patrick A. Doheny-Foy No. 6 Oilwell in NE 1/4 NW 1/4 Sec. 21 T2N R58W 6PM. The elevation of the ground at the state is 4600.6 feet above sea level from U.S.C. & G. Bench Mark.

Fort Morgan, Colorado
March 12, 1967

Cecil J. Osborne
Registered Professional Engineer
State of Colorado



00076353

21-2N-58W

67-76

#67-74