


CERTIFICATE OF SURVEY
for
Patrick A. Doherty
Morgan County, Colorado

Colo Cons Com
RECEIVED

MAR - 2 1967

COLO. OIL & GAS CONS. COMM.

T2N R58W6PM

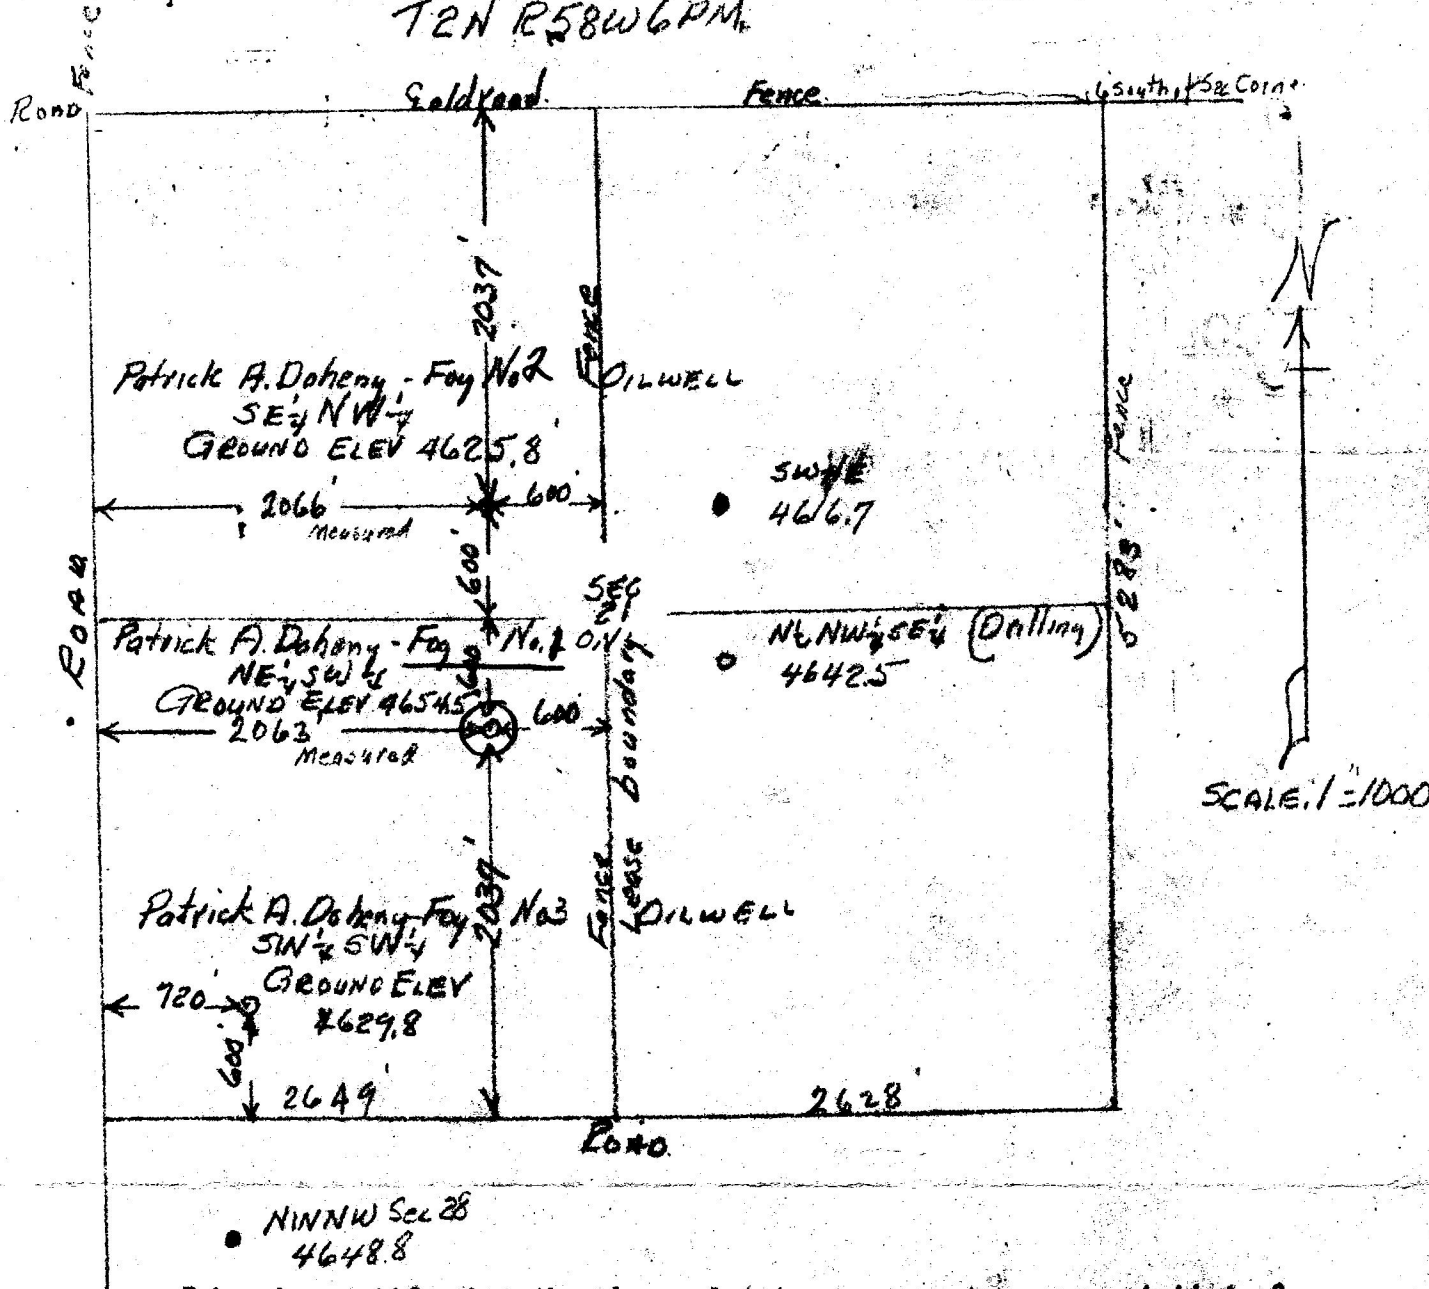

I hereby certify that the above plat is an accurate representation of a correct survey showing the location of Patrick A. Doherty Foy No. 1 Oilwell in NE 1/4 SW 1/4 Sec. 21 T2N R58W 6PM. Ground elevation 4654.5 feet above sea level; Patrick A. Doherty - Foy No. 2 Oilwell in SE 1/4 NW 1/4 Sec. 21 T2N R58W 6PM. Ground elevation 4625.8 feet above sea level. Patrick A. Doherty - Foy No. 3 Oilwell in SW 1/4 SW 1/4 Sec. 21 T2N R58W 6PM. The elevation of the ground at the stake 4629.8 feet above sea level from U.S.C. & G.S. Bench Mark.

East Morgan, Colorado
Mar. 26, 1967

Lee J. Roberson
Registered Professional Engineer
State of Colorado



00076309

67-51

21-2N-58-1 Foy