

CERTIFICATE OF SURVEY
for
H.L.Hunt
Morgan County, Colorado




00054855

BEST IMAGE
AVAILABLE

RECEIVED
OCT 24 1963

OIL & GAS
CONSERVATION COMMISSION

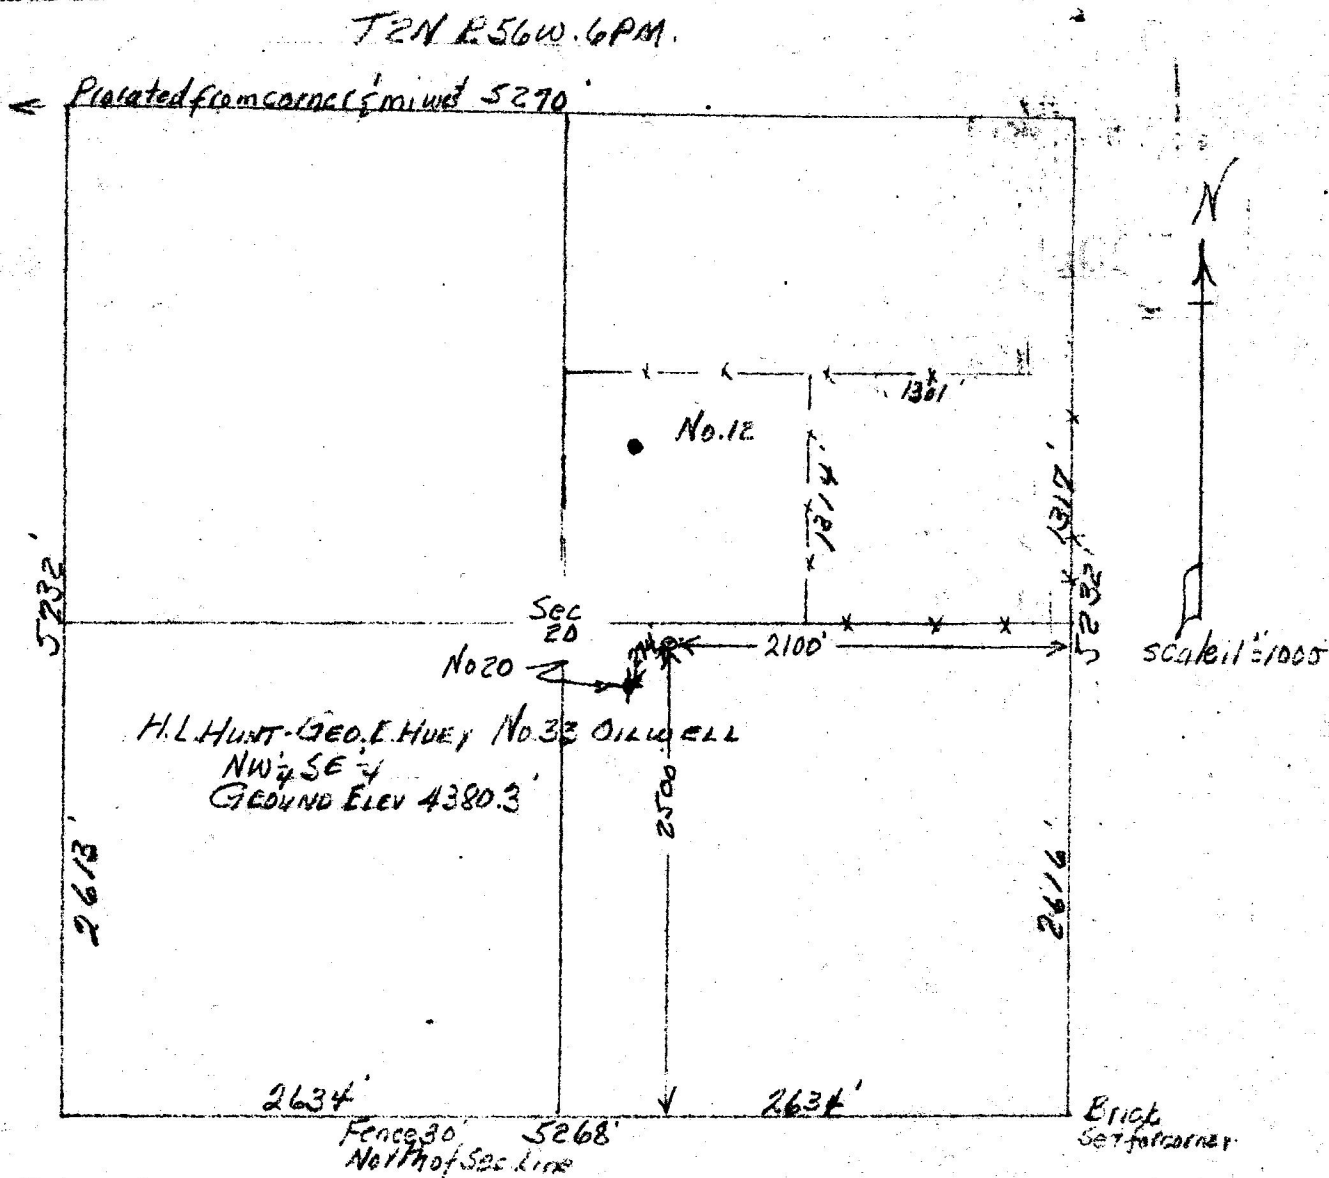

I hereby certify that the above plat is an accurate representation of a correct survey showing the location of H.L.Hunt-Geo. E. Huey No.33 Oilwell in NW 1/4 SE 1/4 Sec. 20 T2N R56W 6PM. The elevation of the ground at the site is 4380.3 feet above sea level from U.S.B.R. Bench Mark.

Fort Morgan, Colorado
Oct. 14, 1963

Lecil J. Claborn
Registered Professional Engineer
State of Colorado