


CERTIFICATE OF SURVEY
for
Okmar Oil Co.
Morgan County, Colorado

RECEIVED

JUL 10 1969

COLO. OIL & GAS CONS. COMM.

00054907

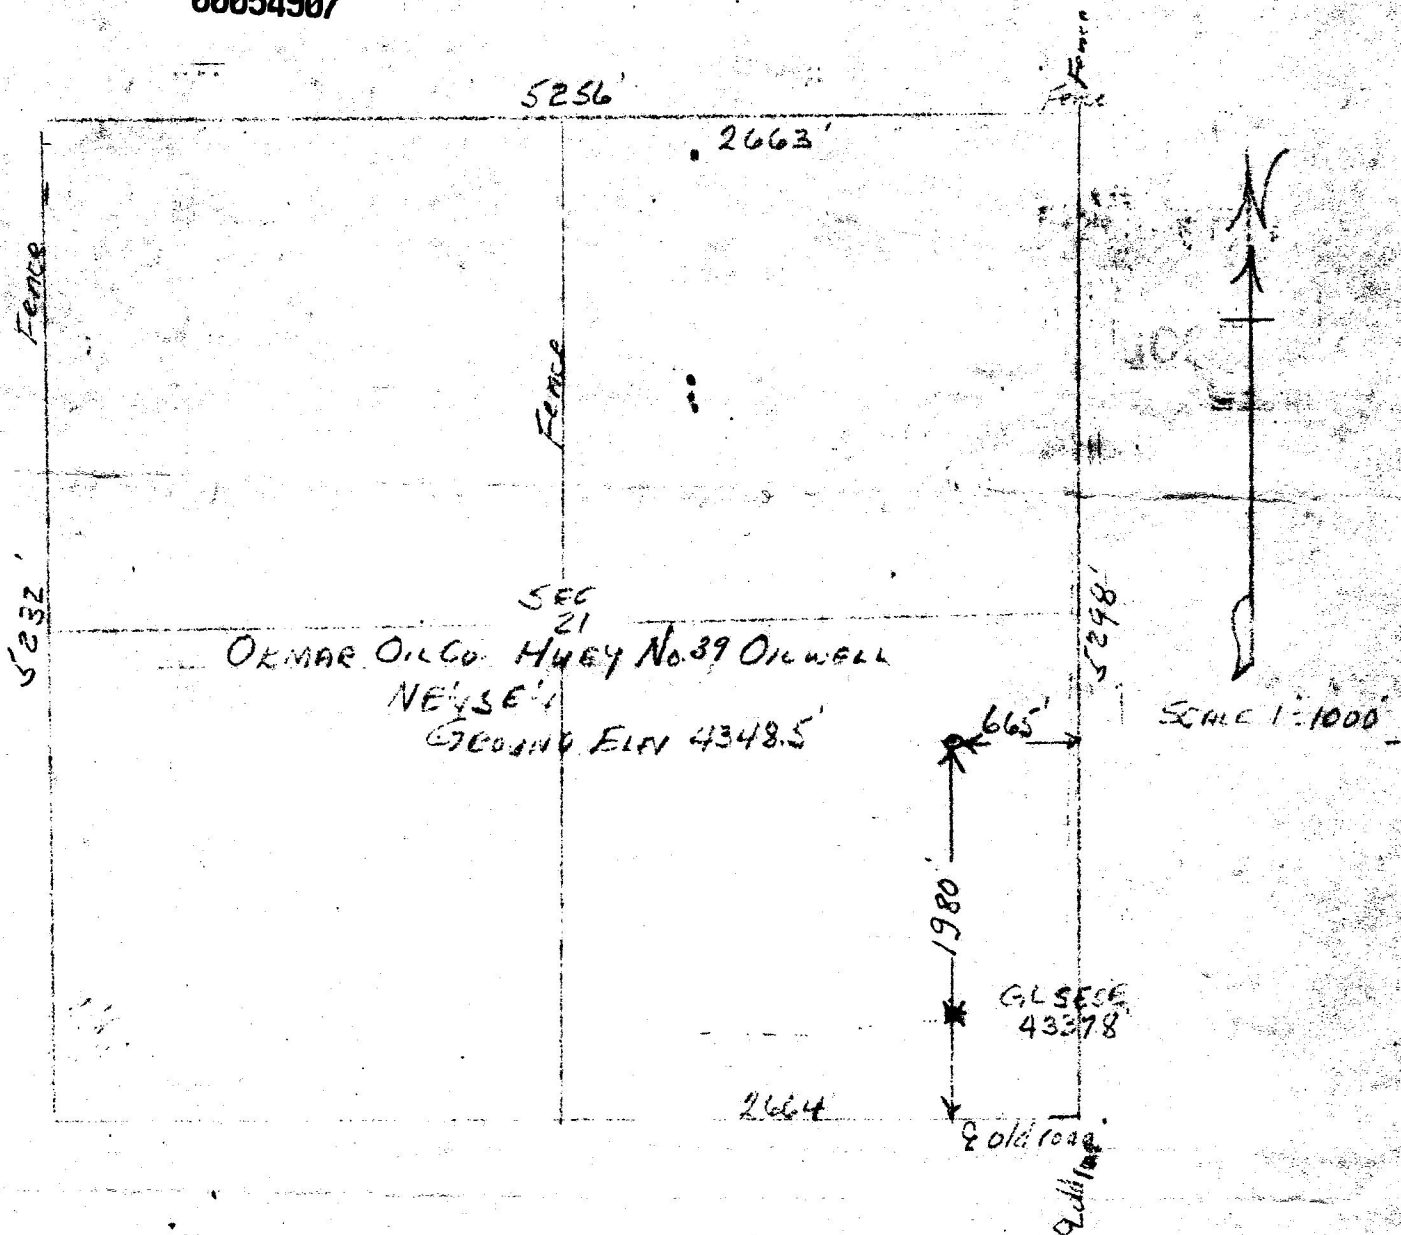

I hereby certify that the above plat is an accurate representation of a correct survey showing the location of Okmar Oil Co. Huey No. 39 Oilwell in NE 1/4 SE 1/4 Sec. 21 T2N R56W 6PM. The elevation of the ground at the stake is 4348.5 feet above sea level from U.S.G.S. Bench Mark.

Fort Morgan, Colorado
June 1, 1969

David J. Osborne
Registered Professional Engineer
State of Colorado

68-252